


CORNER RESTORATION

CORNER: 1/4 corner between Section 34, T2N, R23E
and Section 3, T1N, R23E, W.M.

ORIGINAL SURVEY BY: David P. Thompson

CONTRACT NUMBER: 119

CONTRACT DATE: February 15, 1867

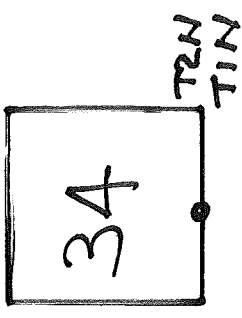

ORIGINAL DESCRIPTION: Set post in mound of earth with charred stake pits. No bearing objects.

RESTORATION BY, STAMP, AND DATE:

Benjamin B. Beseda, PLS 50800
Field Work completed June 24, 2011
Field Crew: Kelly McCargar, PLS 60179

**EVIDENCE FOUND:**

Corner position falls at the intersection of ancient fences running north and west from this location. No evidence of the original corner was found. West of this location the fence has been rebuilt south of the ancient fence remains by as much as 15 feet.

DESCRIPTION OF MONUMENTS AND ACCESSORIES SET AND METHODS USED:

With no traces of the original monument found, the corner position was accepted to be at the intersection of the ancient fences running north and west from this location.

Set 5/8" x 30" rebar with 2-1/2" diameter stamped aluminum cap at the 1/4 corner position.
Monument is set 0.1 feet +/- out of ground.

The following references being 5/8" x 30" rebar with yellow plastic cap stamped "B BESEDA PLS #50800" were set flush with natural ground and bear as follows from the 1/4 corner, unless otherwise noted.

1. North 26°53'58" West 11.26 feet.
2. North 52°06'31" East 25.09 feet.
3. South 39°41'49" East 49.32 feet.
4. South 01°26'50" East 15.20 feet.

