


CORNER RESTORATION

CORNER: Corner common to Sections 4, 5, 8 & 9,
T1N, R23E, W.M.

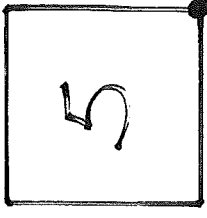

ORIGINAL SURVEY BY: B.J. Pengra


CONTRACT NUMBER: 119

CONTRACT DATE: February 15, 1867

ORIGINAL DESCRIPTION: Set charred stake in raised mound. No bearing objects.

RESTORATION BY, STAMP, AND DATE:

Benjamin B. Beseda, PLS 50800
Field Work completed July 12, 2011
Field Crew Bradley R. Huffmon, PLS 2786

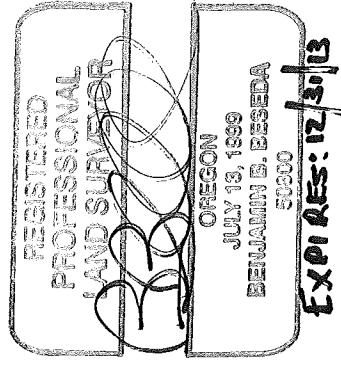

EVIDENCE FOUND:

Corner position falls at the intersection of ancient fences running to the east, west and north from this location. The surrounding ground has been subject to past and/or current cultivation on all sides. No evidence of the original corner was found.

DESCRIPTION OF MONUMENTS AND ACCESSORIES SET AND METHODS USED:

With no traces of the original monument found, the corner position was accepted to be at the intersection of the ancient fences running to the east, west and north from this location.

Set 5/8"x 30" rebar with 2-1/2" diameter stamped aluminum cap at section corner position.
Monument is set flush with the ground.

Set 5/8" rebar with yellow plastic cap stamped "B BESEDA PLS #50800" as references as follows from the section corner:

1. North 89°42'00" East 39.92 feet. Set in east west fence.
2. South 22°55'37" West 52.23 feet.
3. North 89°48'47" West 40.43 feet. Set in east west fence.
4. North 02°44'30" West 32.20 feet. Set on west side of north south fence.

All references are set flush with ground surface.

