

OREGON CORNER RESTORATION FORM

SECTION 22 TOWNSHIP 1N RANGE 23 E P-17

COUNTY: UMATILLA DATE 12/92

CORNER DESIGNATION

East 1/4 corner.

CONDITION REPORT ONLY
 NOT FOUND
 RENEWED
 UNRECORDED
 SURVEYED IN
 REFERENCED OUT

PREVIOUS RENEWALS/SURVEYS, ETC.

Originally surveyed in 1865 by Thompson under Contract #109. He set 12" x 8" x 6" stone.

MONUMENTS & ACCESSORIES FOUND: Condition and Source
Found a 12" x 8" x 6" stone at the East end of an old fence berm with a small mound of stones around it.

MONUMENT DETAIL

SKETCH

T1N R23E
 1/4
 22 23
 1992
 LS 951

MONUMENT SET (PROCEDURES AND DESCRIPTION)

In place of stone I set a 1" x 30" iron pipe with a 2 3/8" Brass Cap, stamped as above, and buried stone along Southwest side.

NEW ACCESSORIES From which

An Alum. tag #951 in Power pole Bears. N 52° 10'E 122.31 feet. Attached Bearing Object sign.
 An Alum. tag #951 in Power pole Bears. N 69° 05'E 212.30 feet. Attached Bearing Object sign.
 A 5/8" rebar with plastic cap #951 Bears. S 89° 28'W 144.52 feet, drove steel fence post with Witness sign attached.
 A 5/8" rebar with plastic cap #951 Bears. N 89° 27'E 65.69 feet.



LOCATION & COMMENTS

From road intersection at Town of Morgan, go East on Co. Rd. O.2 mile to fence line. Go South in bottom of a draw 300+ feet to Corner.

SURVEYOR'S SEAL

COMPASS DEC. FIRM EDWARDS SURVEYING
 P.O. BOX 763, HERMISTON, OREGON, 97838
 PARTY CHIEF D. EDWARDS

NOTES
 WITNESS S. BENEFIT

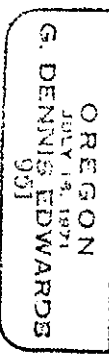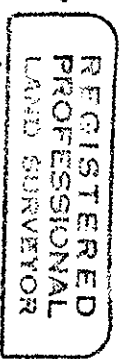

Morrow County Surveyor
 Date 1/26/93
 Rec'd by [Signature]
 No. _____