

OREGON CORNER RESTORATION FORM

Section 27 Township 1N Range 23E
County Morrow Date December 2, 1997


CORNER DESIGNATION

R-15	_____	Condition Report Only
N 1/4	_____	Not Found
	_____	Renewed
	_____	Unrecorded
	<input checked="" type="checkbox"/>	Surveyed In
	<input checked="" type="checkbox"/>	Referenced Out


Previous Renewals/Surveys, etc. Originally set under contract #119 in 1867 by Thompson;
He set a charred stake in a raised sand mound.

Monument(s) & Accessories Found: _____ (Condition and Source)
No evidence of original monumentation found.

Monument Detail

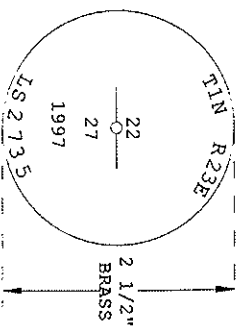

Sketch

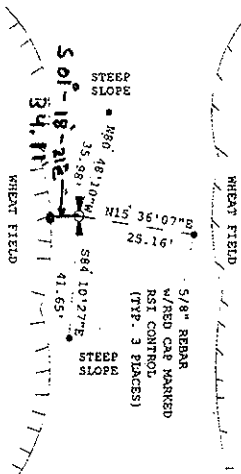

Monument Set (Procedures and Description)

Holding fence corners east and west at section corners, position was determined by single
Sch. 40 steel pipe with 6" flared end and 2 1/2" brass cap. Monument set utilizing Trimble 4000 SSI
Receivers with Real Time Kinematic methods.

New Accessories

- 5/8" rebar with red cap marked RSI control bears N 80°48'10"W 35.98' (grid)
- 5/8" rebar with red cap marked RSI control bears N 15°36'07"E 25.16' (grid)
- 5/8" rebar with red cap marked RSI control bears S 84°10'27"E 41.65' (grid)
- 5/8" rebar with red cap marked RSI control bears S 01° 18' 21" E 34.11 (grid)

Surveyor's Seal

Location & Comments
 NAD 83/91 Oregon North Compass Declination 20 1/2°
 Grid coordinates (Int'l. Feet) Firm/Agency Rogers Surveying
 N: 685665.50
 E: 8349198.70 Address 2304 N. 1st Street
 Referenced from Tri Sta. Hermiston, OR 97838
 Saddle Butte Party Chief E. Todd Pierce
 N: 672388.08 Notes
 E: 8351122.09 Witness *Michael D. Duruga*

