


1-3

CORNER RESTORATION


CORNER: 1/4 corner common to Sections 30 and 31, T1N, R23E, W.M.
ORIGINAL SURVEY BY: David P. Thompson
CONTRACT NUMBER: 119
CONTRACT DATE: February 15, 1867

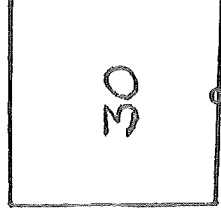

ORIGINAL DESCRIPTION: Set charred stake. No bearing objects.

RESTORATION BY, STAMP, AND DATE:

Benjamin B. Beseda, PLS 50800
Field Work completed January 13, 2012
Field Crew Bradley R. Huffman, PLS 2786, Crew Chief
And Rob Walker, Survey Tech.

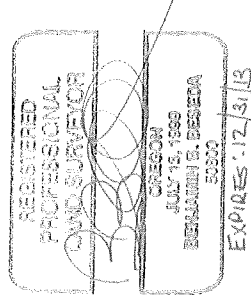

EVIDENCE FOUND:

Corner position falls in plowed field. The land is rolling and has been subject to cultivation for many years. No evidence of the original corner was found.

DESCRIPTION OF MONUMENTS AND ACCESSORIES SET AND METHODS USED:

With no traces of the original monument found, the corner position was determined by single proportion from section corners to the east and west.

Set 5/8"x 30" rebar with 2-1/2" diameter stamped aluminum cap, at 1/4 corner position.
Monument is set 1.5 feet down in the ground.

5/8"x 30" rebar with yellow plastic cap stamped "B BESEDA PLS 50800" flush with the ground bear as references as follows from the 1/4 corner unless otherwise noted:

- 1) North 29° 27' 44" East 110.12'
- 2) South 33° 56' 39" East 82.84'
- 3) South 51° 08' 20" West 49.58' Set down 1.5' in plowed field.
- 4) North 34° 20' 10" West 61.74' Set down 1.5' in plowed field.