

**OREGON CORNER RESTORATION FORM**

Section 27 Township 1N Range 23E

County Morrow Date December 2, 1997

**CORNER DESIGNATION**

V-13  
SW Corner

_____	Condition Report Only
_____	Not Found
_____	Renewed
_____	Unrecorded
<u>X</u>	Surveyed In
<u>X</u>	Referenced Out


Previous Renewals/Surveys, etc. Originally set under contract #119 in 1867 by Thompson;  
He set a charred stake in a raised mound.

**Monument(s) & Accessories Found: (Condition and Source)**

No evidence of original monumentation found. Fencing east and west evidencing possession.

**Monument Detail**

**Sketch**

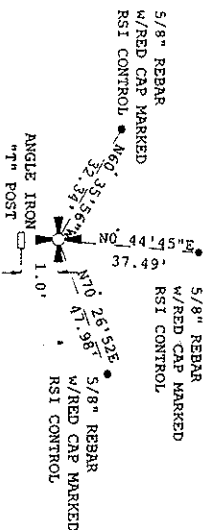

**Monument Set (Procedures and Description)**

Held fence line for northing and single proportioned distance from found fence corners 1 mile east & west  
 Set 1" x 24" sch. 40 pipe with flared end, and 2 1/2 brass cap. Monument set utilizing Trimble  
 4000SSI GPS receivers with Real Time Kinematic methods.

**New Accessories**

- 5/8" rebar with red cap marked RSI control bears N 60°35'56"W (grid) 32.34'
- 5/8" rebar with red cap marked RSI control bears N 70°26'52"E (grid) 47.98'
- Angle Iron "T" post - S0°00'00" (grid) 1.00'
- 5/8" rebar with red cap marked RSI control bears N0°44'45"E 37.49 (grid)

**Surveyor's Seal**

**Location & Comments**  
 NAD 83/91 Oregon North Compass Declination 20 1/2°  
 Grid coordinates (Int'l. Feet) Firm/Agency Rogers Surveying  
 N: 680421.50  
 E: 8346574.83 Address 2304 N. 1<sup>st</sup> Street  
 Referenced from Tri Sta. Hermiston, OR 97838  
 Saddle Butte Party Chief E. Todd Pierce  
 N: 6723388.08 Notes  
 E: 8351122.09 Witness Robert P. Sullivan

