

OREGON CORNER RESTORATION FORM

Section 27 Township 1N Range 23E

County Morrow Date November 20, 1997

CORNER DESIGNATION


V-15
S 1/4

Condition Report Only	_____
Not Found	_____
Renewed	_____
Unrecorded	_____
Surveyed In	<input checked="" type="checkbox"/>
Referenced Out	<input checked="" type="checkbox"/>


Previous Renewals/Surveys, etc. Originally set under contract #119 in 1867 by Thompson.
He set a 14" X 8" X 8" stone.

Monument(s) & Accessories Found: (Condition and Source)
No evidence of original monumentation found.

Monument Detail

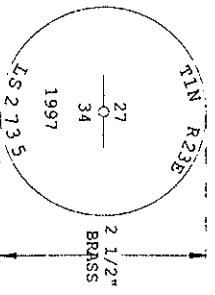

Sketch

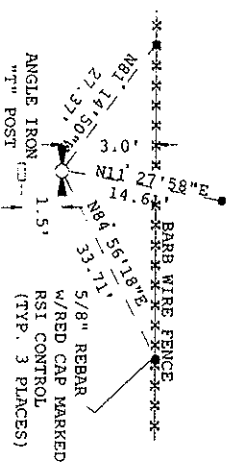

Monument Set (Procedures and Description)

Holding fence corners east and west as section corners, evidencing possession, position was calculated by single proportion and a 24" X 1" sch. 40 pipe, flared at one end, capped with 2 1/2 brass at other, was set utilizing Trimble 4000SSI with Real Time Kinematic methods.

New Accessories

- 5/8" rebar with red cap marked RSI control bears N 84°56'18"E (grid) 33.71'
- 5/8" rebar with red cap marked RSI control bears N 81°14'50"W (grid) 27.37'
- "T" Post bears S 01°W (grid) 1.50'
- 5/8" rebar with red cap marked RSI control bears N 11°27'58"E 14.61'

Surveyor's Seal

Location & Comments
 NAD 83/91 Oregon North Compass Declination 20 1/2°
 Grid coordinates (Int'l. Feet) Firm/Agency Rogers Surveying
 N: 680398.08
 E: 8349207.11 Address 2304 N. 1st Street
 Referenced from Tri Sta. Hermiston, OR 97838
 Saddle Butte Party Chief E. Todd Pierce
 N: 672388.08 Notes
 E: 8351122.09 Witness *Michael A. Baalman*

