


**CORNER RESTORATION**

**CORNER:** 1/4 corner common to Sections 30 and 31, T1N, R23E, W.M.

**ORIGINAL SURVEY BY:** David P. Thompson

**CONTRACT NUMBER:** 119


**CONTRACT DATE:** February 15, 1867

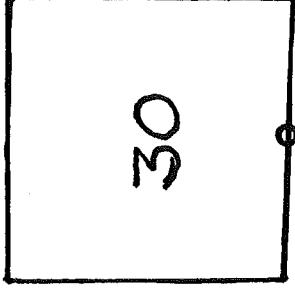

**ORIGINAL DESCRIPTION:** Set charred stake. No bearing objects.

**RESTORATION BY, STAMP, AND DATE:**

Benjamin B. Beseda, PLS 50800  
 Field Work completed January 13, 2012  
 Field Crew Bradley R. Huffmon, PLS 2786, Crew Chief  
 And Rob Walker, Survey Tech.

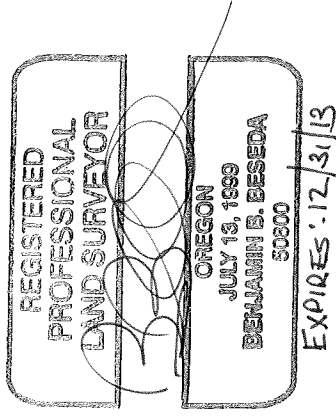**EVIDENCE FOUND:**

Corner position falls in plowed field. The land is rolling and has been subject to cultivation for many years. No evidence of the original corner was found.

**DESCRIPTION OF MONUMENTS AND ACCESSORIES SET AND METHODS USED:**

With no traces of the original monument found, the corner position was determined by single proportion from section corners to the east and west.

Set 5/8"x 30" rebar with 2-1/2" diameter stamped aluminum cap, at 1/4 corner position.  
 Monument is set 1.5 feet down in the ground.

5/8"x 30" rebar with yellow plastic cap stamped "B BESEDA PLS 50800" flush with the ground bear as references as follows from the 1/4 corner unless otherwise noted:

- 1) North 29° 27' 44" East 110.12'
- 2) South 33° 56' 39" East 82.84'
- 3) South 51° 08' 20" West 49.58' Set down 1.5' in plowed field.
- 4) North 34° 20' 10" West 61.74' Set down 1.5' in plowed field.