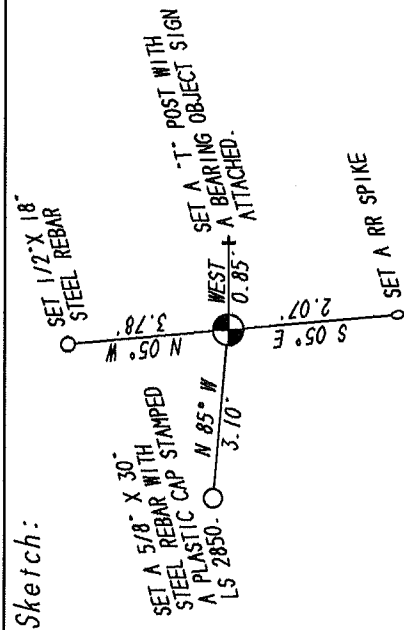
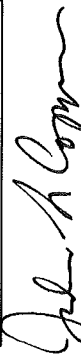


OREGON PUBLIC LAND CORNER REPORT / RESTORATION REPORT

MORROW COUNTY SURVEYOR'S OFFICE

SECTION 15 14 22 23	TOWNSHIP T 1 N	RANGE R 24 E	
MORROW COUNTY		DATE SEPT 2008	
CORNER DESIGNATION: STANDARD SECTION CORNER FOR SECTIONS 15 14 T 1 N. R 24 E OF THE WILLAMETTE MERIDIAN 22 23			
(Please check one) <input type="checkbox"/> Condition Report Only <input checked="" type="checkbox"/> Not Found <input type="checkbox"/> Renewed <input type="checkbox"/> Unrecorded <input checked="" type="checkbox"/> Surveyed In <input checked="" type="checkbox"/> Referenced Out			
Previous Renewals / Surveys, etc. POST WITH MOUND AND PITS BY THOMPSON IN 1867 FOR THE GLO. NO RECORD OR EVIDENCE OF NEWER SURVEYS FOUND.			
Monument(s) & Accessories Found: (Condition & Source) DID NOT CONSIDER THE CORNER LOCATION LOST BECAUSE OF EAST-WEST PLOW LINE AND THE REMAINS OF FENCE INTERSECTION NEAR WHERE YOU WOULD EXPECT IT TO BE. I HELD THAT EVIDENCE AS BEING A PERPETUATION OF THE LOCATION OF THE ORIGINAL CORNER POST SET BY THOMPSON.			
Monument Detail: <div style="border: 1px solid black; border-radius: 50%; width: 100px; height: 100px; margin: 10px auto; display: flex; align-items: center; justify-content: center; text-align: center;"> T 1 N R 24 E 15 14 22 23 2008 LS 2850 </div> FACE OF 2 3/8" BRASS CAP	Sketch: 		
Monument Set (Procedures and Description): DID NOT CONSIDER THE CORNER LOCATION LOST BECAUSE OF EAST-WEST PLOW LINE AND THE REMAINS OF FENCE INTERSECTION NEAR WHERE YOU WOULD EXPECT IT TO BE. I HELD THAT EVIDENCE AS BEING A PERPETUATION OF THE LOCATION OF THE ORIGINAL CORNER POST SET BY THOMPSON AND SET A NEW MONUMENT AT THAT LOCATION AND VERIFIED A REASONABLE FIT OF THE RECORD. "SEE 2007 SURVEY BY ME FOR RIETMANN".			
New Accessories: 1/2" X 18" STEEL REBAR BEARS N 05° W 3.78" "T" POST WITH BEARING OBJECT SIGN ATTACHED BEARS WEST 0.85" RAILROAD SPIKE BEARS S 05° E 2.07" 5/8" X 30" STEEL REBAR WITH A PLASTIC CAP BEARS N 85° W 3.10"			
Location & Comments: THIS LOCATION IS NOT ACCESSIBLE BY PUBLIC ROAD. IT IS LOCATED NEAR THE HEAD OF A NON FARM-ABLE DRAW SURROUNDED BY WHEAT FIELDS. VEHICLE ACCESS LIMITED		Compass Declination: NOT DETERMINED	
Firm / Agency COPPOCK SURVEYING PO Box 495 HEPPNER, OR 97836		SURVEYOR'S SEAL REGISTERED PROFESSIONAL LAND SURVEYOR  OREGON JANUARY 20 1998 JUDSON L. COPPOCK 2850	
Party Chief JUDSON L. COPPOCK LS 2850			
Notes SHANNON BENEFIT		RECEIVED BY Morrow County Surveyor Date <u>Oct 5 2008</u> Rec'd By <u>SKB</u>	
Witness SHANNON BENEFIT		No. <u>P-17</u> OCT 2008	