

# OREGON CORNER RESTORATION FORM

COUNTY: Morrow. DATE: 09/25/09

CORNER DESIGNATION: Z-23, The South 1/4 corner of Section 36, Township 1 North, Range 24 East, W.M.

PREVIOUS RENEWALS/SURVEYS ETC: Corner originally established by David P. Thompson under Contract No. 79 dated July 26, 1858. Notes state: Set post for 1/4 Section Corner and built mound of earth as per instructions.

Dave Krumbain, per survey D-875-K663, in 1988 for Columbia Basin Electric, reported reestablishing the corner position and monumenting with a 2 1/2" brass cap on 1 1/2" iron pipe, in part from information in 1970 unrecorded BPA survey.

MONUMENT AND ACCESSORIES FOUND: Found a p.k. nail 2" below surface of road at position of reported brass cap monument.

## MONUMENT MARKING DETAIL:

SC  
TIN R24E  
1/4 S36  
2009  
PLS 1106

MONUMENT SET: At the position of the recovered p.k. nail, set a 2 3/8" diameter brass cap on a 1"x30" galvanized iron pipe, with top of brass cap 3/4" below pavement and set in concrete in the center of Baseline Road. Cap is marked as shown in "Monument Marking Detail".

## New accessories:

A 5/8" by 24" rebar with 1 1/4" red plastic cap on road shoulder bears N71°E, 35.3 feet.  
A 5/8" by 24" rebar with 1 1/4" red plastic cap on road shoulder bears S68°E, 45.8 feet.  
A 5/8" by 24" rebar with 1 1/4" red plastic cap on road shoulder bears S67°W, 33.6 feet.  
A 3/4" diameter brass washer stamped 'PLS 1106', 1 foot above ground level on power pole no. B1-61 (5-2-5 1/2), bears N64°W, 56.2 feet.

Red plastic caps on rebar accessories are marked "OR PLS 1106 WA PLS 17372". A bearing object sign was wired to each of the rebar accessories and a bearing object sign was nailed to the power pole. Also nailed witness sign to the power pole.

LOCATION AND COMMENTS: Corner is located in center of Baseline Road. A steel tape and magnetic compass were used to measure bearings and distances to accessories.


FIRM: Wells Surveying  
P.O. Box 1696  
Pendleton, OR 97801

COMPASS DECLINATION: 18° East


Surveyor's Seal

Witnesses: Jason Wells, LSIT  
Eddie Kilner

\1N24Z23

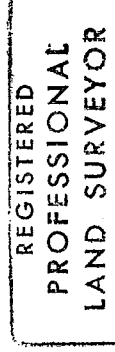

*William R. Wells*

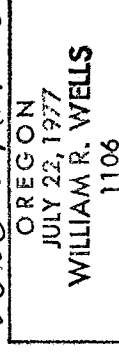

*renews 6-30-10*