

OREGON CORNER RESTORATION FORM

COUNTY: Morrow. DATE: 09/25/09

CORNER DESIGNATION: Z-25, The corner common to Section 36, Township 1 North, Range 24 East, and Section 31, Township 1 North, Range 25 East, W.M.

PREVIOUS RENEWALS/SURVEYS ETC: Corner originally established by David P. Thompson under Contract No. 79 dated July 26, 1858. Notes state: Set post for corner to Townships 1 North of Ranges 24 and 25 East and built a mound of earth as per instructions.

Dave Krumbain, per survey D-875-K663, dated 1988, for Columbia Basin Electric, reported reestablishing the corner position and monumenting with a 2 1/2" brass cap on 1 1/2" iron pipe.

Wells found a p.k. nail at the corner point and a rebar accessory in Partition Plat No. 1993-03.

MONUMENT AND ACCESSORIES FOUND: Found a p.k. nail 2" below surface of road at position of reported brass cap monument.

MONUMENT MARKING DETAIL:

SC
T1N
R24E | R25E
S36 | S31
2009
PLS 1106

MONUMENT SET: At the position of the found p.k. nail, set a 2 3/8" diameter brass cap on a 1"x30" galvanized iron pipe, with top of brass cap 3/4" below pavement and set in concrete near the center of Baseline Road. Cap is marked as shown in "Monument Marking Detail".

New accessories:

A 3/4" diameter brass washer stamped "PLS 1106", 1 foot above ground level on power pole no. B1-51 (5-2-10 1/2), bears N72°E, 71.3 feet.

A 5/8" by 24" rebar with 1 1/4" red plastic cap bears S501/2°E, 25.9 feet.

A 5/8" by 24" rebar with 1 1/4" red plastic cap bears S75°W, 46.2 feet.

A 5/8" by 24" rebar with 1 1/4" red plastic cap bears N69°W, 46.2 feet.

A 5/8" rebar, 18" below ground line from Survey No. D-875-K663 bears North, 20.0'.

Nailed a "witness" sign and a bearing object sign, facing Southwest, to the power pole above the brass washer.

Red plastic caps on rebar accessories are marked "OR PLS 1106 WA PLS 17372". The rebar accessories are set on road shoulder. Wired a bearing object sign to each of the rebar accessories except for the 5/8" rebar 20.0' North of new monument.

LOCATION AND COMMENTS: Corner is located near the center of Baseline Road. A steel tape and magnetic compass were used to measure bearings and distances to accessories.



FIRM: Wells Surveying
P.O. Box 1696
Pendleton, OR 97801

COMPASS DECLINATION: 18° East

Surveyor's Seal

Witnesses: Jason Wells, LSIT
Eddie Kilner

\\IN24Z25

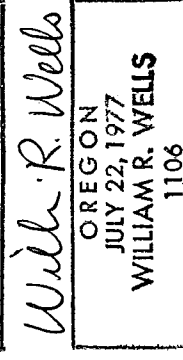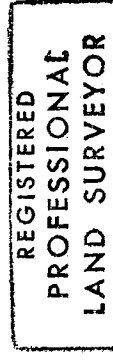

renews 6-30-10