

**CERTIFIED RECORD OF LAND CORNER MONUMENTATION**


T.1N., R.25E., INDEX A-17

**History of original corner establishment:**

This corner was originally established by David P. Thompson under G.L.O. contract number 122, dated June 13, 1867.

Survey General notes state:

Set post for corner to secs 2,3,34,& 35 in mound of earth with charred stake pits as per instructions.

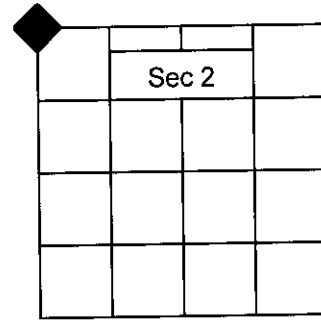

**Description of corner evidence found:**

Found remains of intersection of old south and west coursing fence. Due to it near record relationship to the surrounding accepted corner positions, accepted this position as the best available evidence.

**Description of monument and accessories I establish to perpetuate the original location of this corner:**

At the above said intersection, set a 2-1/2" dia. x 30" aluminum pipe w/3" dia. aluminum cap, stamped as shown in the DIAGRAM, 28" in the ground.

From which;

A 5/8"x 30" rebar pin bears N45°W 12.6 ft. is set 30" deep, with no marks on top of pin.

A 5/8"x 30" rebar pin bears N45°E 8.3 ft. is set 30" deep, filed one groove on top of pin.

A 5/8"x 30" rebar pin bears S45°E 6.2 ft. is set 30" deep, filed 2 grooves on top of pin.

A 5/8"x 30" rebar pin bears S45°W 10.8 ft. is set 30" deep, filed an X on top of pin.

**DIAGRAM**

T2N R25E  
S34 | S35  
S3 | S2  
T1N R25E  
2003  
PLS 49865

Measurements to accessories taken with a magnetic compass, declination 17°-30' East, and distances measured with nylon clad steel tape. Placed yellow plastic caps stamped "FS&E Survey Marker" on all rebar pin accessories.

I hereby certify that the above corner point was perpetuated as shown hereon on February 14, 2003

Witness: D. Mitchell Ferguson, LSIT  
Bradley R. Cates, LSIT



RENEWS: 1/1/2004

Office of County Surveyor County of Morrow  
State of Oregon. I hereby certify that the within instrument was filed in this office  
for record on the 4<sup>th</sup> day of March, 2003 2014

Stephen K. Haddock by \_\_\_\_\_  
County Surveyor Deputy