

CERTIFIED RECORD OF LAND CORNER MONUMENTATION


T.1N., R.25E., INDEX C-17

History of original corner establishment:

This corner was originally established by David P. Thompson under G.L.O. contract number 122, dated June 13, 1867.

Survey General notes state:

Set 1/4 sec post in mound of earth with charred stake pits as per instructions.

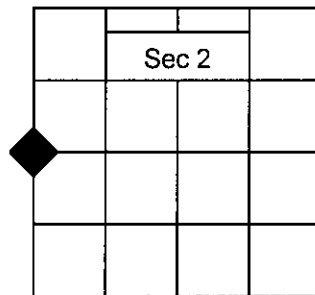

Description of corner evidence found:

Searched for, no evidence found. Corner lost to farming, road improvements and or time. Set at proportionate measure.

Description of monument and accessories I establish to perpetuate the original location of this corner:

At the position determined by Survey, Morrow County Survey No. C-1340-M, set a 2-1/2"dia.x 30" aluminum pipe w/3"dia. aluminum cap, stamped as shown in the DIAGRAM, 28" in the ground.

From which;

A 5/8"x 30" rebar pin bears N45°W 12.1 ft. is set 27" deep, with no marks on top of pin.

A 5/8"x 30" rebar pin bears N45°E 11.9 ft. is set 27" deep, filed one groove on top of pin.

A 5/8"x 30" rebar pin bears S45°E 11.4 ft. is set 27" deep, filed 2 grooves on top of pin.

A 5/8"x 30" rebar pin bears S45°W 12.2 ft. is set 27" deep, filed an X on top of pin.

DIAGRAM

T1N R25E
1/4
S3 | S2
2003
PLS 49865

Measurements to accessories taken with a magnetic compass, declination 17°-30' East, and distances measured with nylon clad steel tape. Placed yellow plastic caps stamped "FS&E Survey Marker" on all rebar pin accessories.

I hereby certify that the above corner point was perpetuated as shown hereon on February 21, 2003

Witness: D. Mitchell Ferguson, LSIT
Bradley R. Cates, LSIT



RENEWALS: 1/1/2004

Office of County Surveyor County of Morrow
State of Oregon. I hereby certify that the within instrument was filed in this office
for record on the 4th day of March, 2003-2014

Stephen K. Haddock by _____
County Surveyor Deputy