

CERTIFIED RECORD OF LAND CORNER MONUMENTATION


T.1N., R.25E., INDEX E-17

History of original corner establishment:

This corner was originally established by David P. Thompson under G.L.O. contract number 122, dated June 13, 1867.

Survey General notes state:

Set stone 19x13x9 for corner to secs 2,3,10&11.

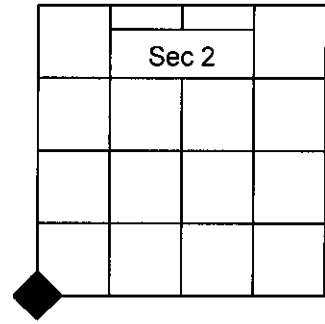

Description of corner evidence found:

Found a stone of near record call size set 4" in the ground under an old north, south fence line. A south and west fence corner bears N01°21'18"E, 28.57 feet.

Description of monument and accessories I establish to perpetuate the original location of this corner:

At the position of the above said stone, set a 2-1/2"dia.x 30" aluminum pipe w/3"dia. aluminum cap, stamped as shown in the DIAGRAM, 27" in the ground, and placed call size stone north alongside.
From which;

A 5/8"x 30" rebar pin bears N45°W 11.5 ft. is set 30" deep, with no marks on top of pin.

A 5/8"x 30" rebar pin bears N45°E 11.9 ft. is set 30" deep, filed one groove on top of pin.

A 5/8"x 30" rebar pin bears S45°E 13.6 ft. is set 30" deep, filed 2 grooves on top of pin.

A 5/8"x 30" rebar pin bears S45°W 10.5 ft. is set 30" deep, filed an X on top of pin.

DIAGRAM
 T1N R25E
 S 3 | S2
 S10 | S11
 2003
 PLS 49865

Measurements to accessories taken with a magnetic compass, declination 17°-30' East, and distances measured with nylon clad steel tape. Placed yellow plastic caps stamped "FS&E Survey Marker" on all rebar pin accessories.

I hereby certify that the above corner point was perpetuated as shown hereon on February 14, 2003

Witness: D. Mitchell Ferguson, LSIT
Bradley R. Cates, LSIT

**REGISTERED
PROFESSIONAL
LAND SURVEYOR**

OREGON
JULY 13, 1999
KENNETH H. DELANO JR.
#49865

RENEWS: 1/1/2004

Office of County Surveyor _____ County of Morrow
State of Oregon. I hereby certify that the within instrument was filed in this office
for record on the 4th day of March, 2003 2014

Stephen K. Haddock by _____
County Surveyor Deputy