


CERTIFIED RECORD OF LAND CORNER MONUMENTATION

T.1N., R.25E., INDEX E-21

History of original corner establishment:

This corner was originally established by David P. Thompson under G.L.O. contract number 122, dated June 13, 1867. Survey General notes state:

Set post for corner to secs 1,2,11&12 in mound of Earth with charred stake & pits as per instructions.

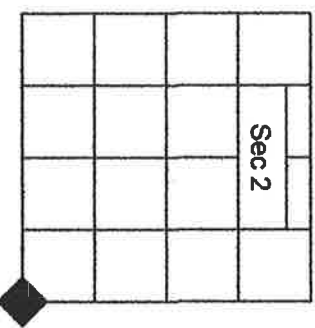

Description of corner evidence found:

Accepted a long standing south and east fence corner. See NARRATIVE on sheet 1, Morrow County Map of Survey C-1340-M

Description of monument and accessories I establish to perpetuate the original location of this corner:

At the position of the above said fence corner, set a 2-1/2"dia.x 30" aluminum pipe w/3"dia. aluminum cap, stamped as shown in the DIAGRAM, 26" in the ground, from which;

A 5/8"x 30" rebar pin bears N45°W 15.7 ft. Top is set 1 foot below ground, with no marks on top of pin.

A 5/8"x 30" rebar pin bears N45°E 19.8 ft. Top is set 1 foot below ground, filed one groove on top of pin.

A 5/8"x 30" rebar pin bears S45°E 13.1 ft. is set 27" deep, filed 2 grooves on top of pin.

A 5/8"x 30" rebar pin bears S45°W 17.3 ft. is set 30" deep, filed an X on top of pin.



Measurements to accessories taken with a magnetic compass, declination 17°-30' East, and distances measured with nylon clad steel tape. Placed yellow plastic caps stamped "FS&E Survey Marker" on all rebar pin accessories.

I hereby certify that the above corner point was perpetuated as shown hereon on February 13, 2003

Witness: D. Mitchell Ferguson, LSIT
Bradley R. Cates, LSIT

RENEWAL DATE 12/31/2003

Office of County Surveyor _____ County of MORROW
State of Oregon _____ I hereby certify that the within instrument was filed in this office
for record on the _____ day of _____, 2003

County Surveyor _____ by _____ Deputy