


**CERTIFIED RECORD OF LAND CORNER MONUMENTATION**

T.1N., R.25E., INDEX E-25

**History of original corner establishment:**

This corner was originally established by Ebenezer E. Haft under G.L.O. contract number 99, dated July 8, 1861. Survey General notes state:

Deposited a pint of charcoal set a post for corner to sec 1,6,7,&12 and raised a mound with trench and pits as per instructions.

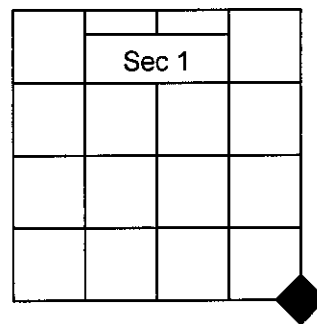

**Description of corner evidence found:**

Found the intersection of long standing north, south and west fence. Due to it near record relationship to the surrounding accepted corner positions, accepted this position as best available evidence.

**Description of monument and accessories I establish to perpetuate the original location of this corner:**

At the above said intersection, set a 2-1/2" dia. x 30" aluminum pipe w/3" dia. aluminum cap, stamped as shown in the DIAGRAM, 27" in the ground.

From which;

A 5/8"x 30" rebar pin bears N45°W 13.9 ft. is set 30" deep, no marks on top of pin.

A 5/8"x 30" rebar pin bears N45°E 21.5 ft. is set 30" deep, filed 1 groove on top of pin.

A 5/8"x 30" rebar pin bears S45°E 15.8 ft. is set 30" deep, filed 2 grooves on top of pin.

A 5/8"x 30" rebar pin bears S45°W 12.8 ft. is set 30" deep, filed an X on top of pin.


**DIAGRAM**

T1N  
R25E R26E  
S1|S6  
S12|S7  
2003  
PLS49865

Measurements to accessories taken with a magnetic compass, declination 17°-30' East, and distances measured with nylon clad steel tape. Placed yellow plastic caps stamped "FS&E Survey Marker" on all rebar pin accessories.

I hereby certify that the above corner point was perpetuated as shown hereon on February 14, 2003

Witness: D. Mitchell Ferguson, LSIT  
Bradley R. Cates, LSIT

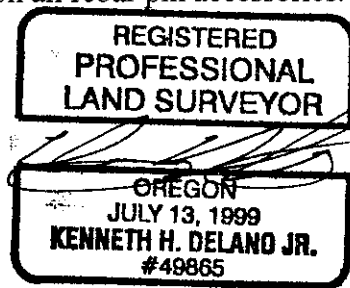

RENEWS: 1/1/2004

Office of County Surveyor County of Morrow  
State of Oregon. I hereby certify that the within instrument was filed in this office  
for record on the 4<sup>th</sup> day of March, ~~2003~~ 2014

Stephen K. Haddock by \_\_\_\_\_  
County Surveyor Deputy