


CERTIFIED RECORD OF LAND CORNER MONUMENTATION

T. 1N., R. 26E., INDEX A-5

History of original corner establishment:

This corner was originally established by Ebenezer E. Haft under G.L.O. contract number 99, dated July 8, 1861. Survey General notes state:

Deposited a pint of charcoal set a post for corner to sec 5,6,31,&32 and raised a mound with trench and pits as per instructions.

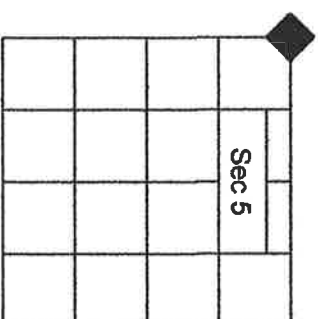

Description of corner evidence found:

Found the intersection of County Road No. 759(Bombing Range Rd.), an easterly coursing road and a westerly coursing fence line. Due to its near record relationship to surrounding accepted corner positions, accepted this position as the best available evidence.

Description of monument and accessories I establish to perpetuate the original location of this corner:


At the above said intersection, set a P.K. nail in pavement at corner location. From which;

A 2-1/2"x 30" aluminum pipe with a 3" aluminum cap set 29" in the ground bears S45°W, 33.4 feet. Cap is stamped as shown in the DIAGRAM.

A 5/8"x 30" rebar pin bears N45°W 31.4 ft. is set 30" deep.

A 5/8"x 30" rebar pin bears N45°E 36.8 ft. is set 30" deep, filed 1 groove on top of pin.

A 5/8"x 30" rebar pin bears S45°E 35.6 ft. is set 30" deep, filed an X on top of pin.

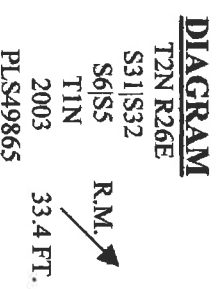

Measurements to accessories taken with a magnetic compass, declination 17°-30' East, and distances measured with nylon clad steel tape. Placed yellow plastic caps stamped "FS&E Survey Marker" on all rebar pin accessories.

I hereby certify that the above corner point was perpetuated as shown hereon on February 20, 2003

Witness: D. Mitchell Ferguson, LSIT
Bradley R. Cates, LSIT

RENEWAL DATE 12/31/2003

Office of County Surveyor _____ County of MORROW
State of OREGON . I hereby certify that the within instrument was filed in this office
for record on the _____ day of _____, 2003

County Surveyor _____ by _____ Deputy