

**OREGON CORNER RESTORATION FORM**

Section 12 Township 1N Range 26E  
 County Morrow Date: September 24, 2016

Corner Designation: 1N26J25

Corner to sections 12 and 13, T1N, R26E and sections 7 and 18, T1N, R27E, W.M., Morrow County, Oregon.

Condition Report Only  
 Not found  
 Remonumented  
 Unrecorded  
 Surveyed in  
 Referenced out


Previous Renewals / Surveys, etc.

Corner originally set by Ebenezer E. Haft under contract No. 93 dated September 11, 1860. His record reads: Set post for corner to Secs. 7, 18, 12 & 13 in mound with trench & pits & deposited a pint of charcoal as per instructions. In the record of private surveys Book 1, Page 32, County Surveyor Loy Turner found a rotted end of a fence post and charcoal. He set a 1/16th"x4"x6 foot strap steel folded in thirds on top of the charcoal, built a mound of stone around the steel and dug pits on the section lines.

Monument and Accessories found: ( condition and source )  
 None. The area has been heavily plowed.

**DIAGRAM**

**SKETCH**

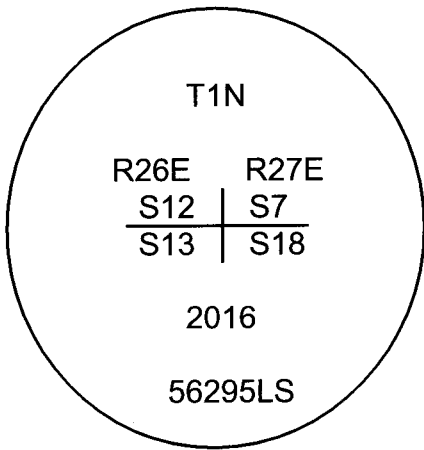

**MONUMENT (S) AND ACCESSORIES SET (Procedures and Description)**

I set a 1 1/2" x 30" galvanized iron pipe with a 2 1/4" brass cap stamped as shown in the diagram above at the position determined by single proportion. The monument is 20 inches below the surface of the field.

For references, I set four, 5/8" by 24" rebars with 1 1/8" orange plastic caps attached, stamped WTS and 56295LS as described below:

- an iron rebar bears N02°25'28"E, 23.89 feet, 20 inches below the surface of the field;
- an iron rebar bears S89°52'23"E, 24.54 feet, 20 inches below the surface of the field;
- an iron rebar bears S00°25'37"W, 22.98 feet, 20 inches below the surface of the field;
- an iron rebar bears S89°57'19"W, 23.93 feet, 20 inches below the surface of the field;

The monument was set and references tied using a Trimble R7/R8 RTK GPS.

Location and comments

Compass Declination

Surveyors Seal

**RECEIVED BY:**

Morrow County Surveyor  
 Date: 9-28-2016  
 Rec'd By: S.K.H.  
 No. 1N26J25

Firm / Agency  
 Witness Tree Surveying  
 Address  
 P.O. Box G  
 Pilot Rock, Or. 97868  
 Party Chief  
 Stephen K, Haddock

REGISTERED  
 PROFESSIONAL  
 LAND SURVEYOR

*Stephen K. Haddock*

OREGON  
 JULY 9, 2001  
 STEPHEN K. HADDOCK  
 56295LS

RENEWS: 6-30-17