

CERTIFIED RECORD OF LAND CORNER MONUMENTATION


T.1N., R.26E., INDEX J-5

History of original corner establishment:

This corner was originally established by Ebenezer E. Haft under G.L.O. contract number 99, dated July 8, 1861.

Survey General notes state:

Deposited a pint of charcoal set a post for corner to sec 7,8,17,& 18 and raised a mound with trench and pits as per instructions.

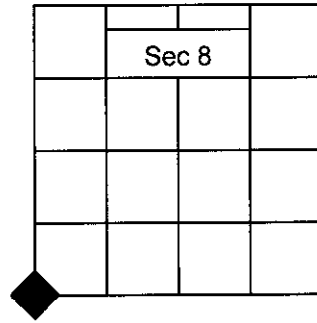

Description of corner evidence found:

Found the intersection of county road No. 759(Bombing Range Rd.) and an easterly coursing fence line. Due to its near record relationship to surrounding accepted corner positions, accepted this position as the best available evidence.

Description of monument and accessories I establish to perpetuate the original location of this corner:


At the above said intersection, set a P.K. nail in pavement at corner location. From which;

A 2-1/2"x 30" aluminum pipe with a 3" aluminum cap set 25" in the ground and raised a 2-1/2 ft. dia. ring of stone around pipe, bears N54°-00'-38"E 46.2 feet. Cap is stamped as shown in the DIAGRAM.

A 5/8"x 30" rebar pin bears N17°-08'-44"W 75.4 ft. is set 28" deep, no marks on top of pin.

A 5/8"x 30" rebar pin bears S40°-10'-23"E 39.4 ft. is set 28" deep, filed 1 groove on top of pin.

A 5/8"x 30" rebar pin bears S38°-44'-06"W 36.8 ft. is set 28" deep, filed an X on top of pin.

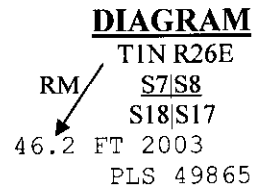

Measurements to accessories taken with a WILD TCA 1100. Placed yellow plastic caps stamped "FS&E Survey Marker" on all rebar pin accessories.

I hereby certify that the above corner point was perpetuated as shown hereon on February 21, 2003

Witness: D. Mitchell Ferguson, LSIT
Bradley R. Cates, LSIT



Office of County Surveyor _____ County of Morrow
State of Oregon. I hereby certify that the within instrument was filed in this office for record on the 4th day of March, 200—2014

Stephen K. Harbock by _____
County Surveyor Deputy