


**CERTIFIED RECORD OF LAND CORNER MONUMENTATION**

T.1N., R.26E., INDEX I-5

**History of original corner establishment:**

This corner was originally established by Ebenezer E. Haft under G.L.O. contract number 99, dated July 8, 1861. Survey General notes state:

Deposited a pint of charcoal set a post for gr sec corner and raised a mound with trench and pits as per instructions.

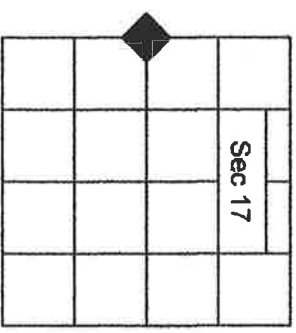

**Description of corner evidence found:**

Found the intersection of county road No. 759(Bombing Range Rd.) and an easterly coursing fence line. Due to its near record relationship to surrounding accepted corner positions, accepted this position as the best available evidence.

**Description of monument and accessories I establish to perpetuate the original location of this corner:**


At the above said intersection, set a P.K. nail in pavement at corner location. From which;

A 2-1/2"x 30" aluminum pipe with a 3" aluminum cap set 26" in the ground, bears N45°E 48.0 feet. Cap is stamped as shown in the DIAGRAM.

A 5/8"x 30" rebar pin bears N45°W 40.7 ft. is set 27" deep, no marks on top of pin.

A 5/8"x 30" rebar pin bears S45°E 42.5 ft. is set 27" deep, filed 1 groove on top of pin.

A 5/8"x 30" rebar pin bears S45°W 43.6 ft. is set 27" deep, filed an X on top of pin.

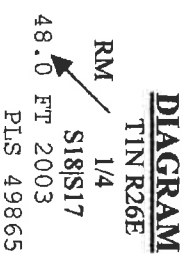

Measurements to accessories taken with a magnetic compass, declination 17°-30' East, and distances measured with nylon clad steel tape. Placed yellow plastic caps stamped "FS&E Survey Marker" on all rebar pin accessories.

I hereby certify that the above corner point was perpetuated as shown hereon on February 21, 2003

Witness: D. Mitchell Ferguson, LSIT  
Bradley R. Cates, LSIT

RENEWAL DATE 12/31/2003

Office of County Surveyor \_\_\_\_\_ County of MORROW  
State of Oregon \_\_\_\_\_ I hereby certify that the within instrument was filed in this office  
for record on the \_\_\_\_\_ day of \_\_\_\_\_, 2003

County Surveyor \_\_\_\_\_ by \_\_\_\_\_ Deputy