

OREGON CORNER RESTORATION FORM

Section _____ Township 1N Range 28 S 29 E

County Morrow Date 7/10/86

P-25

CORNER DESIGNATION

Condition Report Only

1/4 R 28 E R 29 E
S 24 | S 19

- Not Found
- Renewed
- Unrecorded
- Surveyed In
- Referenced Out

Previous Renewals/Surveys, etc. _____


None since original GLO surveys

Monument(s) & Accessories Found: (Condition and Source)

Found Rock mound in old fence lines also fit distances North and South reasonably well

Monument Detail

Sketch

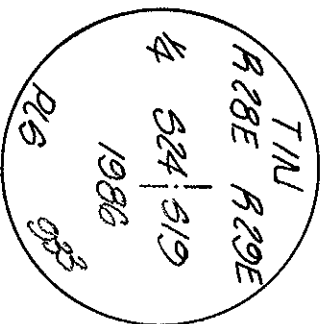

See Morrow County Surveyor
Drawing No. D-828-K

Monument Set (Procedures and Description)

Set 2 1/2" Brass Cap on 1 1/2" x 30" iron pipe in rock mound

New Accessories
None

Location & Comments

Surveyor's Seal

Drive through fields of _____

Rita Clark _____

RECEIVED BY

Morrow County Surveyor

Date 7/28/86

Rec'd By MLD

No. 836-K