

OREGON CORNER RESTORATION FORM

Section 21/22 Township 1N Range 28E

9-13

County Morrow Date 4/24/85

CORNER DESIGNATION

Condition Report Only

- Not Found
- Renewed
- Unrecorded
- Surveyed In
- Referenced Out

S 1/16 S 21 S 22

Previous Renewals/Surveys, etc.

Never Set


Monument(s) & Accessories Found: (Condition and Source)

None

Monument Detail

Sketch

See Morrow County Surveyor
Drawing No. D-828-K

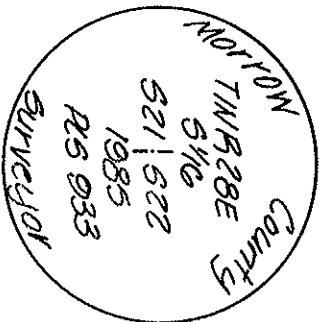

Monument Set (Procedures and Description)

Set 2 1/2" Brass Cap on 1 1/2" x 30" pipe set 26" in ground. Single proportioned from corner set to South and fence corner to North

New Accessories

Set sign on fence post

Location & Comments

Corner lies 350 feet North Compass Declination of Big Butler Creek Road, Firm/Agency Krumbein 2600 feey East of entrance Engineering Ltd. to Vey Ranch Address P.O. Box 1126 Pendleton, Oregon 97801

Surveyor's Seal

RECORDED BY

Morrow County Surveyor

Date 7/28/86

Rec'd By MLD

No. 858-K

Notes

Witness B. Reynolds