

OREGON CORNER RESTORATION FORM

Section 21/28 Township 1N Range 28E

R-12

County Morrow Date 4/24/85

CORNER DESIGNATION

E 1/16 S 21
S 28 S 28

- Condition Report Only
- Not Found
- Renewed
- Unrecorded
- Surveyed In
- Referenced Out

Previous Renewals/Surveys, etc. _____


None since original GIO surveys _____

Monument(s) & Accessories Found: (Condition and Source)

Monument Detail

Sketch

See Morrow County Surveyor
Drawing No. D-828-K

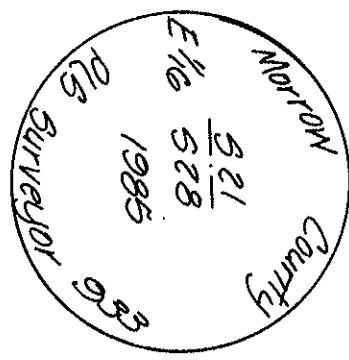

Monument Set (Procedures and Description)

Set 2 1/2" Brass Cap on 1 1/2" x 30" iron pipe by single proportion between quarter corner and section corner

New Accessories

Set steel fence post with sign 1.0 foot North

Location & Comments

540 feet South of Big _____ Compass Declination _____

Surveyor's Seal

Butter Creek Road 1200 feet Firm/Agency Krumbein

East of entrance to Vey _____ Engineering Ltd.

Ranch _____ Address P.O. Box 1126

_____ Pendleton, Oregon 97801

_____ Party Chief J. McRae

_____ Notes _____

_____ Witness B. Reynolds

RECEIVED BY

Morrow County Surveyor

Date 7/28/86

Rec'd By MJD

No. 839-K