

OREGON CORNER RESTORATION FORM

Section _____ Township 1N Range 28E

County Morrow Date 4/24/85

R-13

CORNER DESIGNATION

S 21 | S 22
S 28 | S 27

Condition Report Only
 Not Found
 Renewed
 Unrecorded
 Surveyed In
 Referenced Out

Previous Renewals/Surveys, etc. _____

None since original GLO surveys found _____

Monument(s) & Accessories Found: (Condition and Source)


None

Monument Detail

Sketch

See Morrow County Surveyor

Drawing No. D4828-K

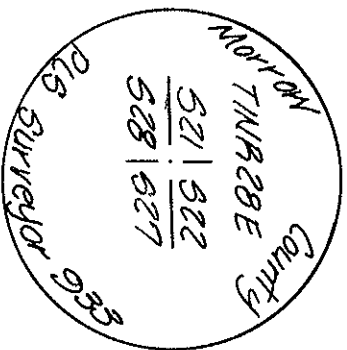

Monument Set (Procedures and Description)

Set 2 1/2" Brass Cap on 1 1/2" x 30" pipe set 24" in ground. Location determined by relating original GLO distances to existing rock mounds, fence corners and road descriptions to determine position and fence line projections. No corners were found in this township

New Accessories

Set steel fence post with sign 1.0 foot North, a 2" iron pipe of unknown origin bears North 62°29'44" East 243.55 feet from this position

Location & Comments

Corner lies 850 feet South Compass Declination _____ of Big Butter Creek Road Firm/Agency Krumbein and 2600 foot East of _____ Engineering Ltd. entrance to Vey Ranch Address P.O. Box 1126'

Surveyor's Seal

RECEIVED BY

Morrow County Surveyors

Date 7/28/85

Rec'd by MLD

No. 840-K

Notes

Witness B. Reynolds