

OREGON CORNER RESTORATION FORM

Section            Township 1 N Range 28 S 29 E

R-25

County Morrow Date 7/10/86

CORNER DESIGNATION

T 1 N

R 28 E R 29 E

S 24 | S 19

S 25 | S 30

Previous Renewals/Surveys, etc.

None since original GLO surveys

Condition Report Only


- Not Found
- Renewed
- Unrecorded
- Surveyed In
- Referenced Out

Monument(s) & Accessories Found: (Condition and Source)

Found old rock crib fence corner with East fence, also fit original  
GLO distances to North and South

Monument Detail

Sketch

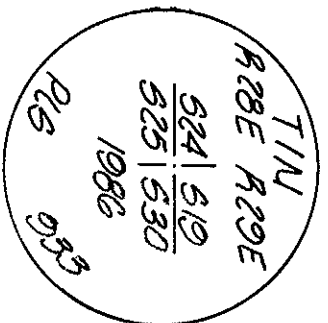

See Morrow County Surveyor  
Drawing No. D-828-K

Monument Set (Procedures and Description)

Set 2 1/2" Brass Cap on 1 1/2" x 30" iron pipe in rock mound

New Accessories  
None

Location & Comments

Drive through fields of            Compass Declination             
Rita Clark, get permission Firm/Agency Krumbein

Engineering Ltd.

Address P.O. Box 1126

Pendleton, Oregon 97801

Party Chief B Reynolds

Notes           

Witness B Kopp II

Surveyor's Seal

RECEIVED BY

Morrow County Surveyor

Date 7/28/86

Rec'd by MUD

No. 837-K