

OREGON CORNER RESTORATION FORM

Section 10 Township 1S Range 23E
 County Morrow Date: April 17, 2019

Corner Designation: 1S23E17


Corner common to sections 2, 3, 10, and 11, T1S, R23E, W.M., Morrow County, Oregon.

Condition Report Only
 Not found
 Remonumented
 Unrecorded
 Surveyed in
 Referenced out

Previous Renewals / Surveys, etc.

The corner was originally set by David P. Thompson under contract 109 dated January 30, 1865. record reads: Set a post for corner to Secs. 2, 3, 10, & 11 in mound of earth with charred stake, pit & c. as per instructions.

Monument and Accessories found: (condition and source)
 None. The point falls in the center of McNab Lane.

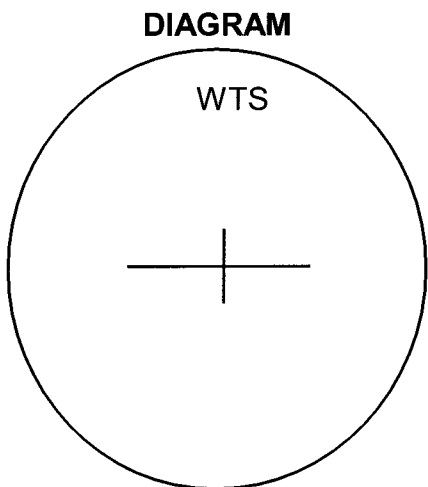

- = RR Spike
- = Rebar Reference
- = Guard Post

MONUMENT (S) AND ACCESSORIES SET (Procedures and Description)

I set a railroad spike in the asphalt marked WTS and having an "X" cut in the top at the position determined by the intersection of field lines to the south and the projection of a fence line to the north with the east-west centerline of McNab Lane.

For references, I set four, 5/8" by 24" rebars with 1.25" orange plastic caps stamped WTS and 56295LS as described below:

- an iron rebar bears N73°10'17"W, 90.34 feet on the south side of a power pole;
- an iron rebar bears N83°37'56"E, 233.49 feet, on the south side of a power pole;
- an iron rebar bears S81°39'51"E, 189.04 feet, at the foot of a wooden fence post;
- an iron rebar bears S01°14'53"W, 24.04 feet, 18" below the surface with a steel guard post with a bearing object sign attached set along side.

Measurements were made with a Trimble RTK GPS.


Location and comments
 Witnessed by:

RECEIVED BY:
Morrow County Surveyor
 Date: 5-27-2019
 Rec'd By: S.K.H.
 No. 1S23E17
 Survey No. _____

Compass Declination

Firm / Agency
 Witness Tree Surveying
 Address
 P.O. Box G
 Pilot Rock, Or. 97868
 Party Chief
 Stephen K. Haddock

Surveyors Seal

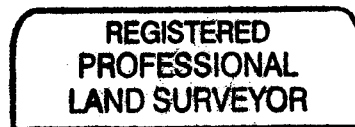

Stephen K. Haddock
 OREGON
 JULY 9, 2001
 STEPHEN K. HADDOCK
 56295LS
 RENEWS: 6-30-21