

OREGON CORNER RESTORATION FORM

Section 10 Township 1S Range 23E
 County Morrow Date: April 12, 2019

Corner Designation: 1S23J13

Corner common to sections 9, 10, 15, and 16, T1S, R23E, W.M., Morrow County, Oregon.


Previous Renewals / Surveys, etc.

The corner was originally set by David P. Thompson under contract 109 dated January 30, 1865. His record reads: Set a post for corner to Secs 9, 10, 15 & 16 in mound of earth with charred stake, pits, &c. as per instructions.


Monument and Accessories found: (condition and source)
 None. This position falls in a plowed field.

Condition Report Only
 Not found
 Remonumented
 Unrecorded
 Surveyed in
 Referenced out

DIAGRAM

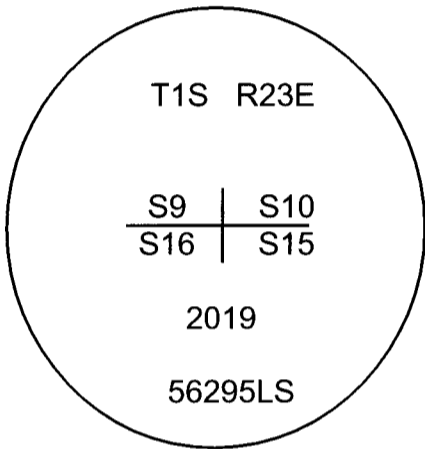

SKETCH

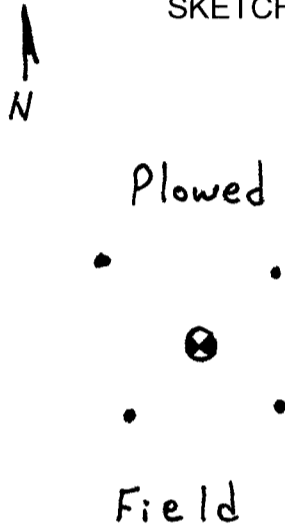

No topographic features nearby.

MONUMENT (S) AND ACCESSORIES SET (Procedures and Description)

I set a 2 3/8" brass cap on a 1 1/2" x 30" galvanized iron pipe 54 inches in the ground at the point determined by proportioning the departure along the projected centerline of Smith Road as per the county road notes. The cap is stamped as shown in the diagram above.

For references, I set four, 5/8" by 24" rebars with 1.25" orange plastic caps stamped WTS and 56295LS as described below:

- an iron rebar bears N45°42'42"W, 29.02 feet, 20 inches below the surface;
- an iron rebar bears N37°22'07"E, 26.84 feet, 20 inches below the surface;
- an iron rebar bears S56°03'55"E, 24.85 feet, 20 inches below the surface;
- an iron rebar bears S36°18'28"W, 27.33 feet, 20 inches below the surface;

Measurements were made with a Trimble RTK GPS.

Location and comments
 Witnessed by:

RECEIVED BY:
Morrow County Surveyor
 Date: 5-27-2019
 Rec'd By: S.K.H.
 No. 1S23J13
 Survey No. _____

Compass Declination
 Firm / Agency
 Witness Tree Surveying
 Address
 P.O. Box G
 Pilot Rock, Or. 97868
 Party Chief
 Stephen K. Haddock

Surveyors Seal

REGISTERED PROFESSIONAL LAND SURVEYOR
Stephen K. Haddock
 OREGON
 JULY 9, 2001
 STEPHEN K. HADDOCK
 56295LS
 RENEWS: 6-30-21