

OREGON CORNER RESTORATION FORM

Section 10 Township 1S Range 23E
 County Morrow Date: April 8, 2019

Corner Designation: 1S23J17

Corner common to sections 10, 11, 14, and 15, T1S, R23E, W.M., Morrow County, Oregon.


Previous Renewals / Surveys, etc.

The corner was originally set by David P. Thompson under contract 109 dated January 30, 1865. His record reads: Set a post for corner to Secs 10, 11, 14 & 15 in mound of earth with charred stake, pits, &c. as per instructions.


Monument and Accessories found: (condition and source)
 None. This position falls in the center of the county road.

Condition Report Only
 Not found
 Remonumented
 Unrecorded
 Surveyed in
 Referenced out

DIAGRAM

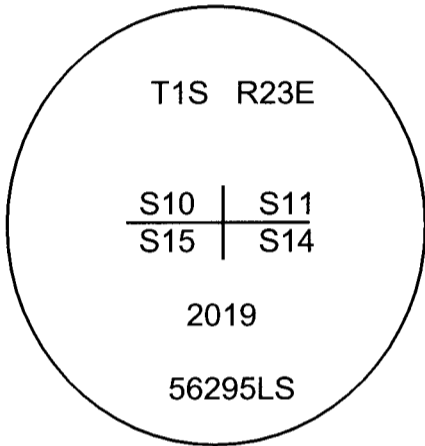

SKETCH

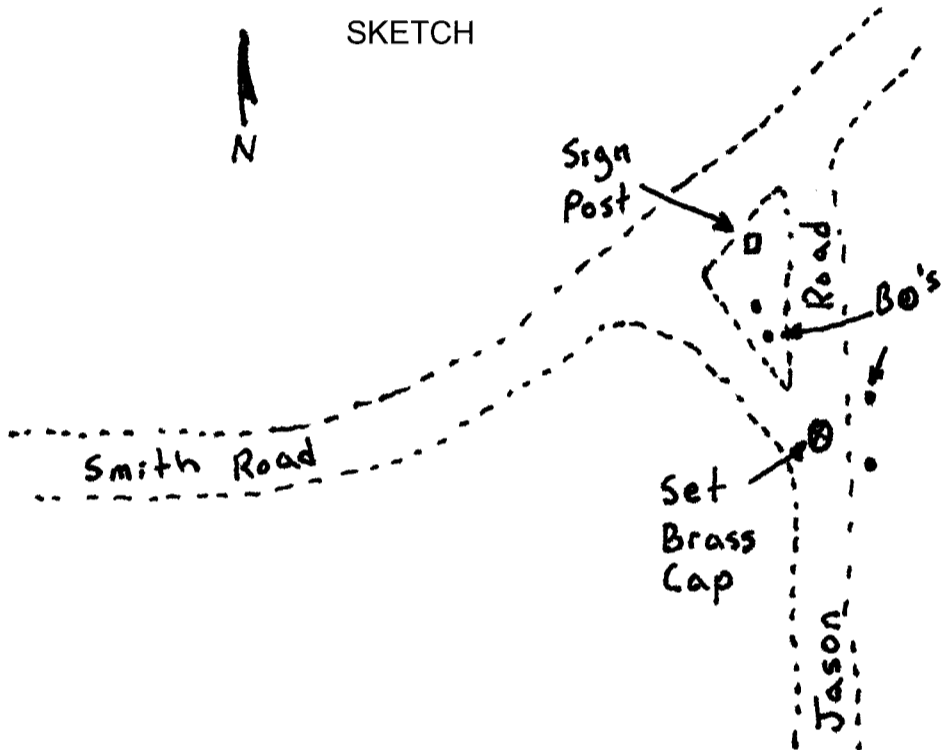

MONUMENT (S) AND ACCESSORIES SET (Procedures and Description)

I set a 2 3/8" brass cap on a 1 1/2" x 30" galvanized iron pipe 36 inches in the ground at the intersection of the centerlines of Jason and Smith roads. The cap is stamped as shown in the diagram above.

For references, I set four, 5/8" by 24" rebars with 1.25" orange plastic caps stamped WTS and 56295LS as described below:

- an iron rebar bears N33°56'30"W, 76.53 feet, flush with the surface;
- an iron rebar bears N34°11'23"W, 51.33 feet, flush with the surface;
- an iron rebar bears N39°26'22"E, 28.95 feet, 18 inches below the surface;
- an iron rebar bears S43°54'43"W, 25.13 feet, 18 inches below the surface;

Measurements were made with a Trimble RTK GPS.

Location and comments
 Witnessed by:

RECEIVED BY:
 Morrow County Surveyor
 Date: 5-27-2019
 Rec'd By: S.K.H.
 No. 1S23J17
 Survey No. _____

Compass Declination
 Firm / Agency
 Witness Tree Surveying
 Address
 P.O. Box G
 Pilot Rock, Or. 97868
 Party Chief
 Stephen K. Haddock

Surveyors Seal

**REGISTERED
 PROFESSIONAL
 LAND SURVEYOR**

Stephen K. Haddock

OREGON
 JULY 9, 2001
STEPHEN K. HADDOCK
 56295LS

RENEWS: 6-30-21