

CORNER RESTORATION FORM

Township 1 SOUTH Range 24 EAST Section 6 County MORROW

State OREGON Date 3/13/14 Number A-1

Corner Designation : NW CORNER SECTION 6

- Condition Report Only
- Not Found
- Renewed
- Surveyed In
- Referenced

Previous Renewals: original source of corner


ORIGINAL CORNER WAS SET BY D.P. THOMPSON IN 1865
UNDER CONTRACT No. 109, WHICH WAS A POST IN A MOUND
OF EARTH WITH CHARRED STAKE WITH PITTS AS PER
INSTRUCTIONS.

Monument (s) Found: (Condition and Source)
FOUND A FENCE CORNER WITH FENCE RUNNING TO EAST AND
WEST AND TO THE SOUTH. ACCEPTED AS BEST EVIDENCE OF
CORNER POSITION.


Accessories Found:
NO ACCESSORIES WERE FOUND.

MONUMENT DETAIL

- Found
- Set

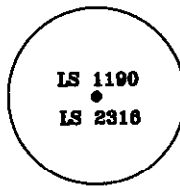

SET 5/8" X 30" REBAR WITH YELLOW PLASTIC CAP REFERENCE

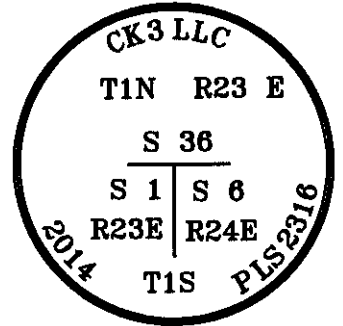

SET 5/8" X 30" REBAR WITH 3-1/4" ALUM CAP AT CORNER

Monument & Accessories Set (Procedure and Description)

SET A 5/8"X30" REBAR WITH A 3-1/4" ALUMINUM CAP MARKED AS SHOWN ABOVE AT FENCE CORNER 6" BELOW GROUND.

SET FOUR REFERENCES AS SHOWN IN THE DIAGRAM BELOW WHICH ARE 5/8"X30" REBARS WITH A YELLOW PLASTIC CAP MARKED AS SHOWN ABOVE.

Sketch of Monument, Accessories and General Area

REGISTERED PROFESSIONAL LAND SURVEYOR

Danny K. Cummings

OREGON
JAN. 21, 1988
DANNY K. CUMMINGS
2316

RENEWS: 12/31/2015

Agency: CK3, LLC
 368 SW 5th AVE
 ONTARIO, OR 97914

Party Chief **D. CUMMINGS**
 Notekeeper **D. CUMMINGS**
 Witness(s) **R. FRITZ**
 Field Book **0-199**
 Client **MONTY CRUM**
 Job # **SO-02020**

COUNTY SURVEYOR FILING INFO

Received 4-14-2014
 Filed S.K.H.
 Survey No. 2014-1699C
 Index No. A-1