

OREGON CORNER RESTORATION FORM

COUNTY: Morrow. DATE: 01/20/09

CORNER DESIGNATION: A-21, The closing corner common to Sections 1 and 2, Township 1 South, Range 24 East, W.M..

PREVIOUS RENEWALS/SURVEYS ETC: Corner originally established by David P. Thompson under Contract No. 109 dated January 30, 1865. Notes state: Set for corner to Secs. 1 & 2 in mound of earth with charred stake, pits & etc., as per instructions.

Dave Krumbain shows a fence corner at this point, with fences East and South in his Survey No. D-875-K-663, in 1988.

Denny Edwards held the fence corner as the closing corner in his partial section subdivision Survey No. B-896-E, in 1989.

MONUMENT AND ACCESSORIES FOUND: I held a point just Northwest of the existing fence corner with fences extending South and East as best remaining evidence of the corner location.

MONUMENT MARKING DETAIL:

T1N R24E
S 35
S2 | S1
T1S R24E
CC
2009
PLS 1106

MONUMENT SET: Set a 2 3/8" diameter brass cap on a 1 1/4"x30" galvanized iron pipe, 29" in the ground at the Northwest side of a fence corner post with fences South and East. Cap is marked as shown in "Monument Marking Detail".

New accessories:

A 5/8" by 24" rebar with 1 1/4" red plastic cap bears East, 24.4 feet.
A 5/8" by 24" rebar with 1 1/4" red plastic cap bears East, 48.0 feet.
A 5/8" by 24" rebar with 1 1/4" red plastic cap bears South, 22.7 feet.
A 5/8" by 24" rebar with 1 1/4" red plastic cap bears South, 48.1 feet.

Red plastic caps on rebar accessories are marked "OR PLS 1106 WA PLS 17372". The rebar accessories are placed in existing fence lines extending South and East from the corner. Wired a bearing object sign to each of the rebar accessories.

Nailed a "witness" sign, facing Southeast, to the fence corner post by the new corner monument.


LOCATION AND COMMENTS: Corner is located at a fence corner with fences extending East and South, 2900 feet West of Crum County Road. A steel tape and magnetic compass were used to measure bearings and distances to accessory rebars.

FIRM: Wells Surveying
P.O. Box 1696
Pendleton, OR 97801


COMPASS DECLINATION: 18° East

Witnesses: Jason Wells, LSIT

\1S24A21

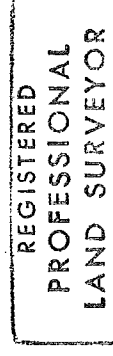

William R. Wells

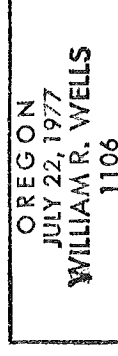

renews 6-30-10

Surveyor's Seal