

# CORNER RESTORATION FORM

Township 1 SOUTH Range 24 EAST Section 4 County MORROW

State OREGON Date 02/07/03 Number C-11

Corner Designation : C1/4 CORNER SEC. 4

- Condition Report Only
- Not Found
- Renewed
- Surveyed In
- Referenced

Previous Renewals \_\_\_\_\_


Monument (s) Found: (Condition and Source)  
ORIGINAL CORNER WAS ESTABLISHED BY D.P. THOMPSON IN  
1865 UNDER CONTRACT No. 109, WHICH WAS A STANDARD  
LOCATION BY SURVEY, NO MONUMENT WAS SET.

### MONUMENT DETAIL

Found  Set

Accessories Found:

NONE

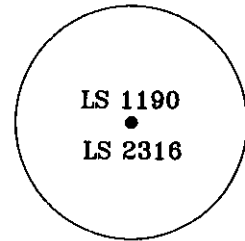

SET 5/8" Ø X 30" REBAR WITH YELLOW PLASTIC CAP.


Monument & Accessories Set (Procedure and Description)

SET 5/8" X 30" REBAR AND CAP 0.20' ABOVE GROUND BY SURVEY.

SET PK IN SW GATE POST, SW 14.45'

SET PK IN SE GATE POST, SE 17.30'

### Sketch of Monument, Accessories and General Area

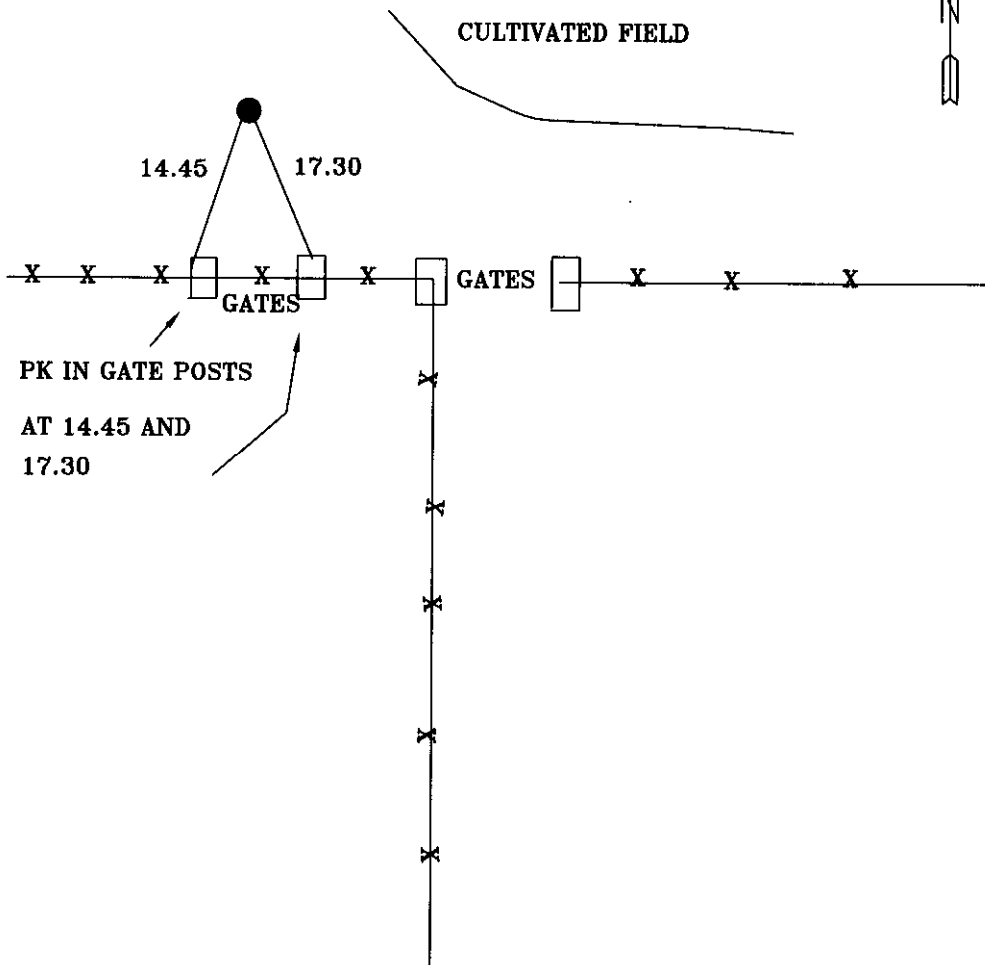

**REGISTERED  
PROFESSIONAL  
LAND SURVEYOR**

*Danny K. Cummings*

**OREGON  
JAN. 21, 1988  
DANNY K. CUMMINGS  
2316**

**RENEWS: 12/31/2015**

Agency: CK3, LLC  
368 SW 5TH AVE  
ONTARIO, OR

Party Chief DAN CUMMINGS

Notekeeper L. KING

Witness(s) LANCE KING

Field Book 0-199

Client MONTY CRUM

Job # SO-02020

**COUNTY SURVEYOR  
RECORDING INFO**

Received 4-14-2014

Filed S.K.H.

Survey No. 2014-1699C

Index No. C-11