

OREGON CORNER RESTORATION FORM

Section 15 Township 1S Range 25E
County Morrow Date: August 11, 2015

Corner Designation: 1S25L17

Condition Report Only
Not found
Remonumented
Unrecorded
Surveyed in
Referenced out

1/4 corner common to sections 14 and 15 T1S, R25E,
W.M., Morrow County, Oregon.


Previous Renewals / Surveys, etc.

Corner was originally set by B.J. Pengra under contract No. 119 Dated February 16, 1867.
His record reads: Set a stone 12x8x? inches corner to 1/4 section. In 1986 under survey C-814-K in folder 526, Dave Krumbain stated he held the intersection of road centerlines and "set a 2 1/2" brass cap with aluminum cap stamped PLS 933".

Monument and Accessories found: (condition and source)

Found a 2 1/2" brass cap set 8 inches below the asphalt at the intersection of roads running north, east, and south.


DIAGRAM

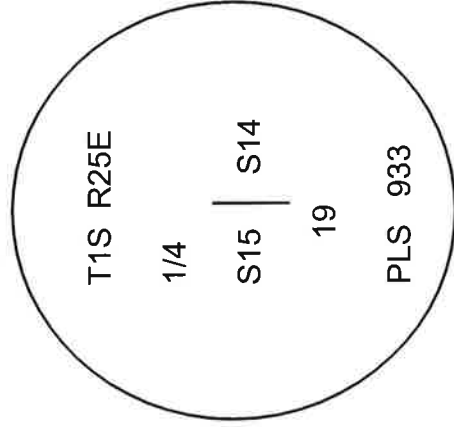

⊗ = Brass Cap

• = Rebar Reference

SKETCH

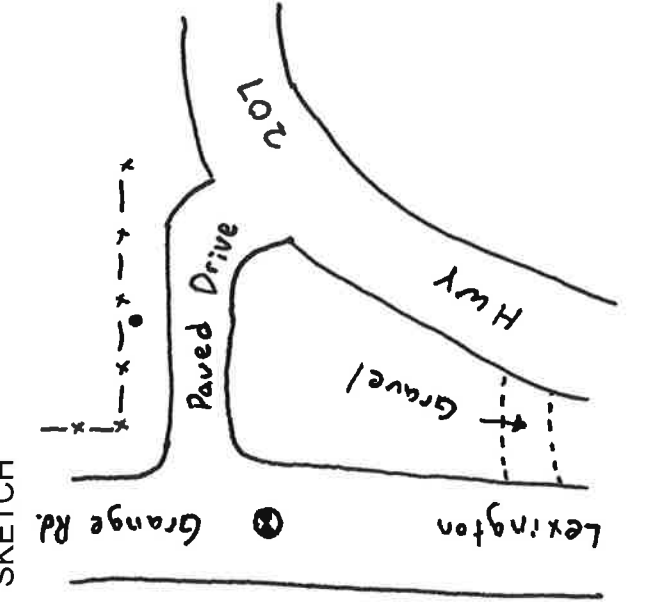

MONUMENT (S) AND ACCESSORIES SET (Procedures and Description)

Left the cap "as is" and set 4 pk nails as straddles in the asphalt.

For references, I set four 5/8" by 24" rebars with 1.25" orange plastic caps stamped WTS and 56295LS as described below:

- a rebar bears N61°49'19"E, 70.83 feet on the south side of a residential yard fence;
- a rebar bears N84°58'39"W, 52.03 feet at the foot of a railroad tie corral post;
- a rebar bears S51°18'38"W, 65.02 feet at the foot of a railroad tie corral post;
- a rebar bears S08°07'21"W, 170.85 feet on the west side of the face of a loading dock;

Measurements to the cap and references were made with a Trimble RTK GPS system.

Location and comments

Witnessed by:

Brenda Johnson
David Quittschreiber

Compass Declination

Surveyors Seal

RECEIVED BY:

Morrow County Surveyor

Date: 9-28-2015

Rec'd By: S.K.H.

No. 1525L17

Survey No. 2015-1748C

Firm / Agency
Morrow County Surveyor

Address

P.O. Box G

Pilot Rock, Or. 97868

Party Chief

Kristina Powell

**REGISTERED
PROFESSIONAL
LAND SURVEYOR**

Stephen K. Haddock

OREGON
JULY 9, 2001
STEPHEN K. HADDOCK
56295LS

RENEWALS: **6-30-17**