

OREGON CORNER RESTORATION FORM

Section 22 Township 1S Range 25E
County Morrow Date: September 2, 2015

Corner Designation: 1S25N13

Condition Report Only
Not found _____
Remonumented x
Unrecorded _____
Surveyed in _____
Referenced out x

Corner common to sections 15, 16, 21, and 22, T1S, R25E,
W.M., Morrow County, Oregon.


Previous Renewals / Surveys, etc.

The corner was originally set by B.J. Pengra under contract 119 dated February 15, 1867. His record reads: Set a stone 14 x 10 x 8 inches as corner to Sections 15, 16, 21 & 22.

Monument and Accessories found: (condition and source)


I found the decayed remains of a wood fence corner post at the intersection of fences running north, south, and west.

DIAGRAM

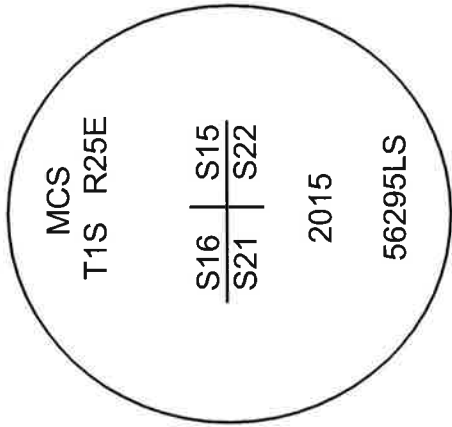

- ⊙ = Brass Cap
- ⊠ = Steel Guard Post
- = Rebar Reference

SKETCH

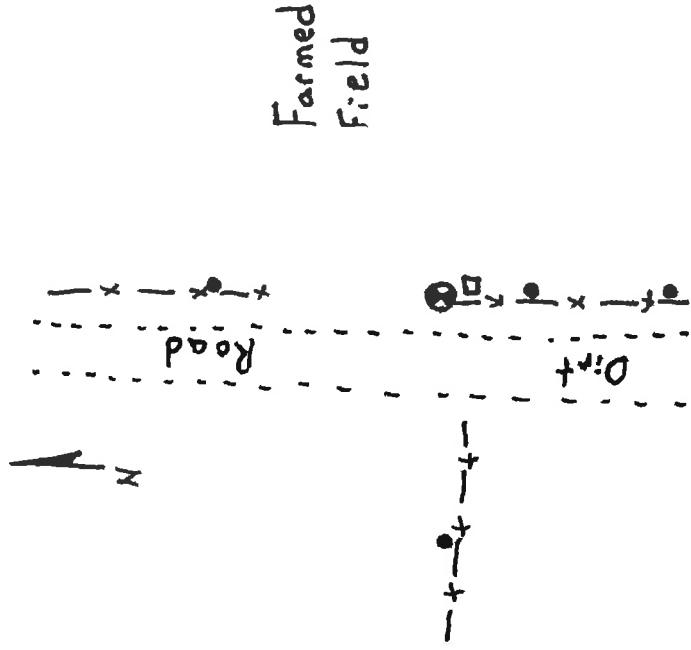

MONUMENT (S) AND ACCESSORIES SET (Procedures and Description)

I set a 2 3/8" brass cap on a 1 1/2" x 30" galvanized iron pipe 30 inches in the ground at the position of the decayed corner post. I set a 6 foot steel guard post along the south side of the new monument.

For references, I set four, 5/8" by 24" rebars with 1.25" orange plastic caps stamped WTS and 56295LS as described below:

- an iron rebar bears N1°12'03"E, 146.28 feet under the existing fence;
- an iron rebar bears S89°17'34"W, 56.32 feet under the existing fence;
- an iron rebar bears S0°09'06"W, 41.05 feet under the existing fence;
- an iron rebar bears S0°08'19"W, 106.31 feet under the existing fence;

Measurements were made with a Trimble RTK GPS.

Location and comments

Witnessed by:
David Quittschreiber

Compass Declination

Surveyors Seal

RECEIVED BY:

Morrow County Surveyor

Date: 9-28-2015

Rec'd By: S.K.H.

No. 1525N13

Survey No. 2015-1748C

Firm / Agency
Morrow County Surveyor

Address

P.O. Box G

Pilot Rock, Or. 97868

Party Chief

Kristina Powell

REGISTERED
PROFESSIONAL
LAND SURVEYOR

Stephen K. Haddock

OREGON

JULY 9, 2001

STEPHEN K. HADDOCK

56295LS

RENEWS: 6-30-17