

**OREGON CORNER RESTORATION FORM**

Section 21 Township 1S Range 25E  
County Morrow Date: September 2, 2015

Corner Designation: 1S25N9

Condition Report Only  
Not found \_\_\_\_\_  
Remonumented x  
Unrecorded \_\_\_\_\_  
Surveyed in \_\_\_\_\_  
Referenced out x

Corner common to sections 16, 17, 20, and 21, T1S, R25E, W.M., Morrow County, Oregon.


Previous Renewals / Surveys, etc.

The corner was originally set by B.J. Pengra under contract 119 dated February 15, 1867. His record reads: Drove charred stake and raised mound as corner to Sections 16, 17, 20 & 21.


Monument and Accessories found: ( condition and source )

A four way fence intersection with fences running north, west, southwest and east. The projection of a plow berm from the south comes to this corner.

**DIAGRAM**

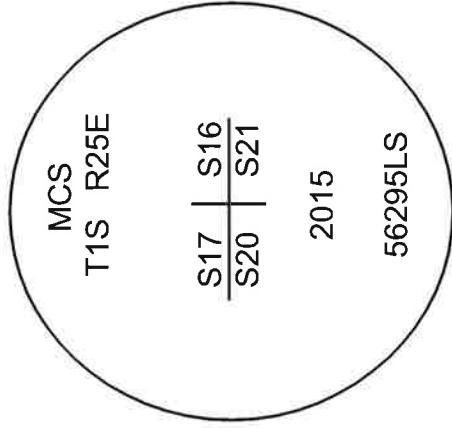

**SKETCH**

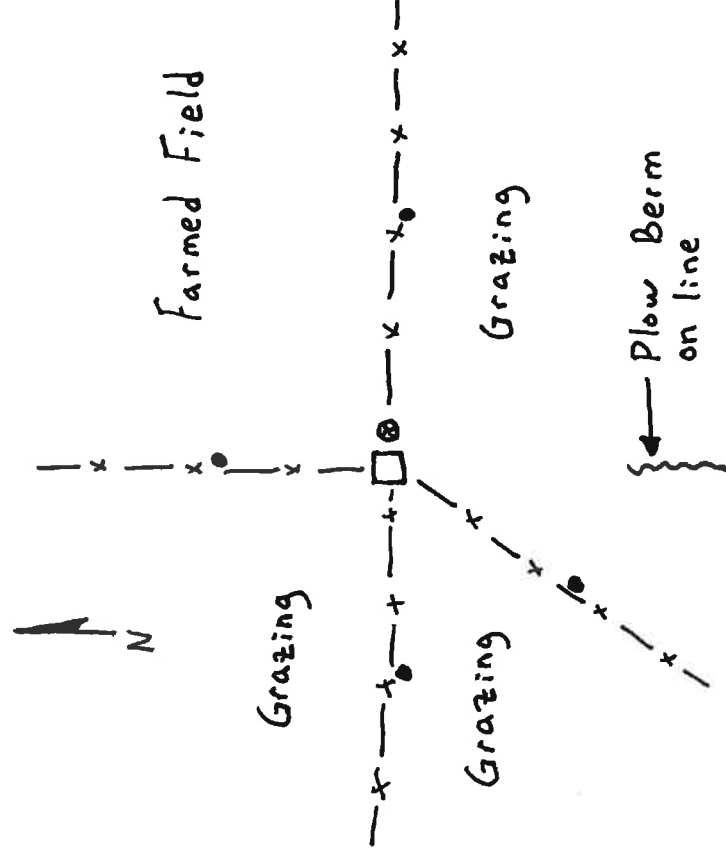

□ = Railroad Tie Fence Post

⊗ = Brass Cap

• = Rebar Reference

**MONUMENT (S) AND ACCESSORIES SET (Procedures and Description)**

I set a 2 3/8" brass cap on a 1 1/2" x 30" galvanized iron pipe 30 inches in the ground at the intersection of the fences as described above.

For references, I set four, 5/8" by 24" rebars with 1.25" orange plastic caps stamped WTS and 56295LS as described below:

- an iron rebar bears N0°55'37"W, 57.13 feet under the existing fence;
- an iron rebar bears S89°40'11"E, 45.27 feet under the existing fence;
- an iron rebar bears N89°24'19"W, 92.84 feet under the existing fence;
- an iron rebar bears S9°11'32"W, 78.30 feet under the existing fence;

Measurements were made with a Trimble RTK GPS.

Location and comments

Witnessed by:  
David Quittschreiber

Compass Declination

Surveyors Seal

**RECEIVED BY:**

Morrow County Surveyor

Date: 9-28-2015

Rec'd By: S.K.H.

No. 1525N9

Survey No. 2015-1748C

Firm / Agency  
Morrow County Surveyor  
Address  
P.O. Box G  
Pilot Rock, Or. 97868  
Party Chief  
Kristina Powell

**REGISTERED  
PROFESSIONAL  
LAND SURVEYOR**

*Stephen K. Haddock*

OREGON  
JULY 9, 2001  
STEPHEN K. HADDOCK  
56295LS

RENEWS: 6-30-17