

OREGON CORNER RESTORATION FORM

Section 27 Township 1S Range 25E
County Morrow Date: September 1, 2015

Corner Designation: 1S25R13



Condition Report Only
Not found _____
Remonumented x
Unrecorded _____
Surveyed in _____
Referenced out x

Corner common to sections 21, 22, 27, and 28, T1S, R25E, W.M., Morrow County, Oregon.

Previous Renewals / Surveys, etc.

The corner was originally set by B.J. Pengra under contract 119 dated February 15, 1867. His record reads: Drove charred stake and raised mound as per instructions as the corner to sections 21, 22, 27 & 28. In survey D-623-K in folder 624, Dave Krumbain states: Brass cap set.

Monument and Accessories found: (condition and source)
The brass capped witness monument in good condition.

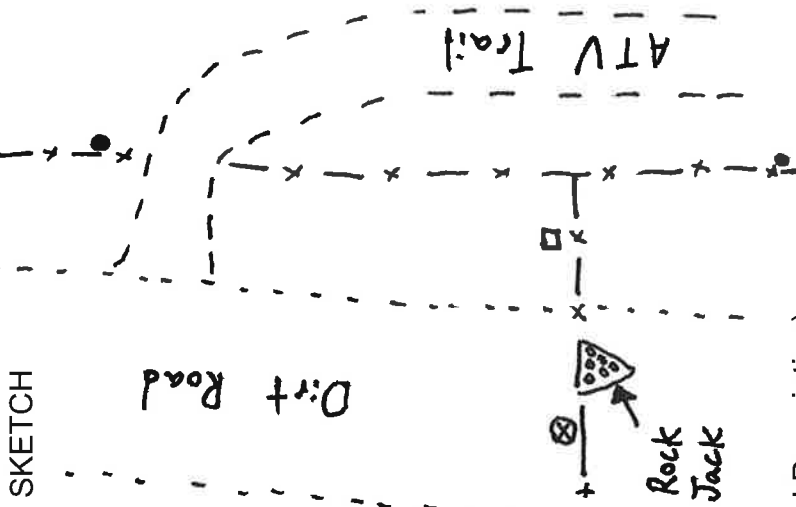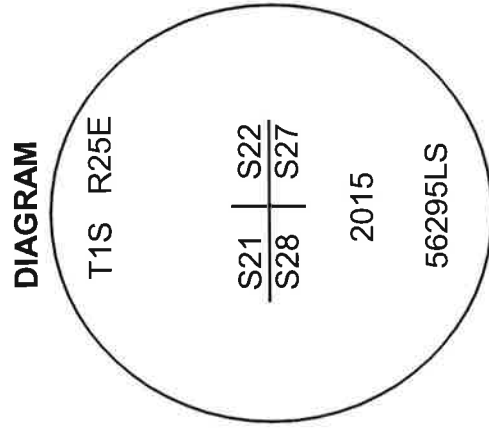

- ⊗ = Brass Cap
- ⊙ = Rebar Reference
- = Brass Capped Witness Monument

MONUMENT (S) AND ACCESSORIES SET (Procedures and Description)

At the point determined by intersecting the north and west section lines determined by the found monuments from survey D-623-K-624, I set a 2 1/2" brass cap on a 1 1/2" x 30" galvanized iron pipe 30 inches in the ground in a road grade scraped to bedrock.

For references, I set three, 5/8" by 24" rebars with 1.25" orange plastic caps stamped WTS and 56295LS as described below:
an iron rebar bears N16°27'28"E, 84.15 feet;
an iron rebar bears S89°14'46"W, 73.89 feet;
an iron rebar bears S28°48'51"E, 51.61 feet;
The 1986 brass capped witness corner monument bears S89°41'04"E 13.80 feet;

Measurements were made with a Trimble RTK GPS.

Location and comments
Witnessed by:
David Quittschreiber

Compass Declination

Surveyors Seal

RECEIVED BY:
Morrow County Surveyor
Date: 9-28-2015
Rec'd By: S.K.H.
No. 1525 R13
Survey No. 2015-1748C

Firm / Agency
Morrow County Surveyor
Address
P.O. Box G
Pilot Rock, Or. 97868
Party Chief
Kristina Powell



RENEWS: **6-30-17**