

**OREGON CORNER RESTORATION FORM**

Section 27 Township 1S Range 25E  
County Morrow Date: September 2, 2015

Corner Designation: 1S25R15

Condition Report Only  
Not found \_\_\_\_\_  
Remonumented X  
Unrecorded \_\_\_\_\_  
Surveyed in X  
Referenced out X


Quarter corner common to sections 22 and 27, T1S, R25E, W.M., Morrow County, Oregon.

Previous Renewals / Surveys, etc.


Corner originally set by B.J. Pengra under contract No. 119 dated February 15, 1867. His record reads: Drove charred stake and raised mound as per instructions for 1/4 Sec. Corner. In Survey D-623-K in folder 624, Dave Krumbain calculated a position for this corner but did not monument it.

Monument and Accessories found: ( condition and source )  
None. The point falls in a plowed field.

**DIAGRAM**

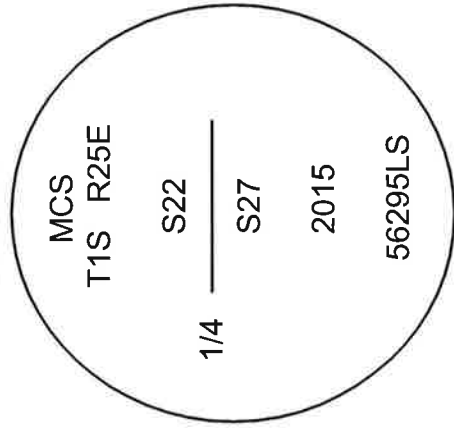

**SKETCH**

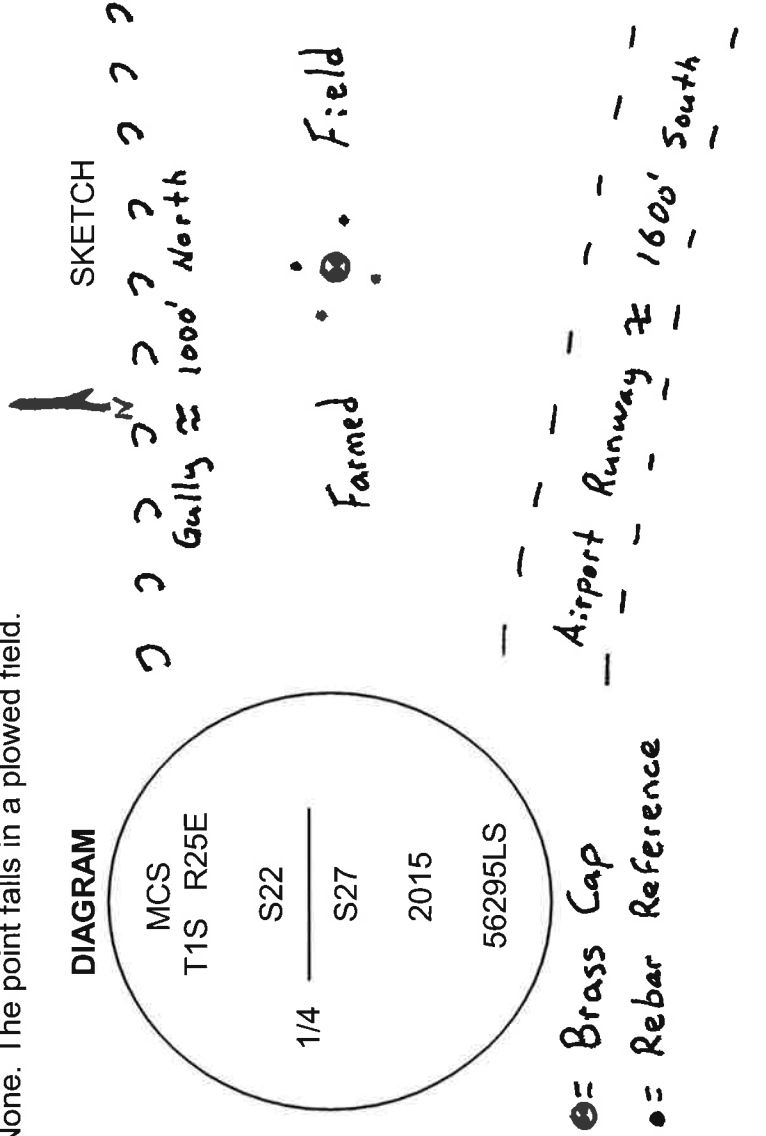

⊙ = Brass Cap  
● = Rebar Reference

**MONUMENT (S) AND ACCESSORIES SET (Procedures and Description)**

At the position established by intersecting the north section line and the north - south center section lines identified by monuments from the Krumbain survey, I set a 2 1/2" brass cap on a 1 1/2" x 30" galvanized iron pipe 54 inches in the ground stamped as shown in the diagram above.

For references I set four, 5/8" by 24" rebars with 1 1/8" orange plastic caps attached, stamped WTS and 56295LS as described below:

- an iron rebar bears N2°35'03"E, 46.57 feet 24 inches below the surface;
- an iron rebar bears S85°26'30"E, 42.72 feet 15 inches below the surface;
- an iron rebar bears S8°11'38"W, 39.72 feet 16 inches below the surface;
- an iron rebar bears N82°12'41"W, 44.75 feet 20 inches below the surface;

The monument and references were tied using a Trimble R7/R8 RTK GPS.

Location and comments

Witnessed By:

David Quittschreiber

Compass Declination

Surveyors Seal

RECEIVED BY:

Morrow County Surveyor

Date: 9-28-2015

Rec'd By: S.K.H.

No. 1525R15

Survey No. 2015-1748C

Firm / Agency

Morrow County Surveyor

Address

P.O. Box G

Pilot Rock, Or. 97868

Party Chief

Kristina Powell

**REGISTERED PROFESSIONAL LAND SURVEYOR**

*Stephen K. Haddock*

OREGON  
JULY 9, 2001  
STEPHEN K. HADDOCK  
56295LS

RENEWS: **6-30-17**