

OREGON CORNER RESTORATION FORM

Section 26 Township 1S Range 25E
County Umatilla Date: October 15, 2013

Corner Designation: 1S25R19

Quarter corner common to sections 23 and 26, T1S, R25E,
W.M., Morrow County, Oregon.

Condition Report Only
Not found
Remonumented x
Unrecorded
Surveyed in
Referenced out


Previous Renewals / Surveys, etc.

Corner originally set by B.J. Pengra under contract No. 119 dated February 15, 1867. His record reads: Drove charred stake and raised mound as per instructions. In June of 1918, County Surveyor Loy M. Turner in the survey in Book 1, Page 37A (See folder 1153) reports: Set a spindle with box off of a 3 1/2" wagon.

Monument and Accessories found: (condition and source)

I found a 2" iron pipe with the end flattened square and a 3/8" x 30" smooth iron rod driven along side in a mound of stone at the corner of fences running N, S, E, and W.

DIAGRAM

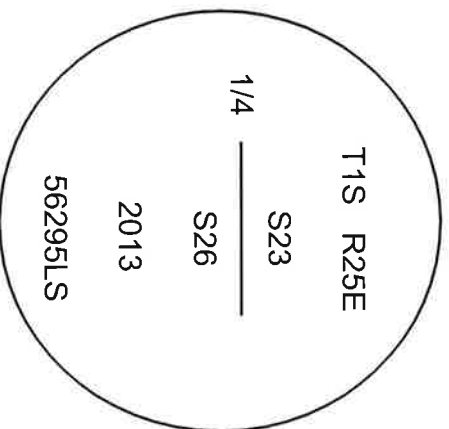

SKETCH

MONUMENT (S) AND ACCESSORIES SET (Procedures and Description)

At the position of the 2" pipe I set a 1 1/2" x 30" galvanized iron pipe with a 2 1/4" brass cap attached stamped as shown in the diagram above.

The references have not been set as yet since the survey under which this work is being performed has not been completed due to complications from FEMA. An updated certificate will be filed upon completion of that survey.

Location and comments

Compass Declination

Surveyors Seal

RECEIVED BY:

Morrow County Surveyor

Date: 12-21-2013

Rec'd By: [Signature]

No. _____

Firm / Agency

Witness Tree Surveying

Address

P.O. Box G

Pilot Rock, Or. 97868

Party Chief

Stephen K, Haddock



[Signature]
STEPHEN K. HADDOCK

OREGON
JULY 9, 2001
STEPHEN K. HADDOCK
56295LS

RENEWS: 6-30-15