

**OREGON CORNER RESTORATION FORM**

Section 28 Township 1S Range 25E  
County Morrow Date: September 3, 2015

Corner Designation: 1S25R9

Condition Report Only  
Not found \_\_\_\_\_  
Remonumented x \_\_\_\_\_  
Unrecorded \_\_\_\_\_  
Surveyed in \_\_\_\_\_  
Referenced out x \_\_\_\_\_

Corner common to sections 20, 21, 28, and 29, T1S, R25E, W.M., Morrow County, Oregon.


Previous Renewals / Surveys, etc.

The corner was originally set by B.J. Pengra under contract 119 dated February 15, 1867. His record reads: Drove charred stake and raised mound as corner to Sections 20, 21, 28 & 29.


Monument and Accessories found: ( condition and source )

An east - west fence intersected with the projection of a fence from the south and a plow berm from the north.

**DIAGRAM**

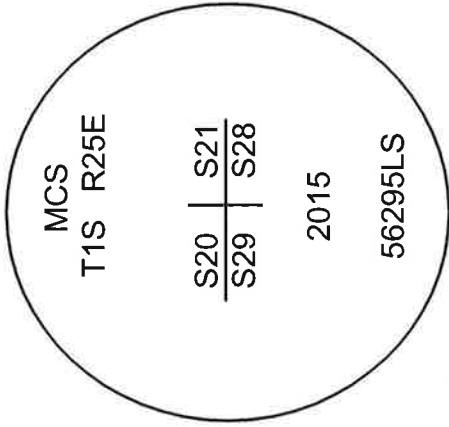

**SKETCH**

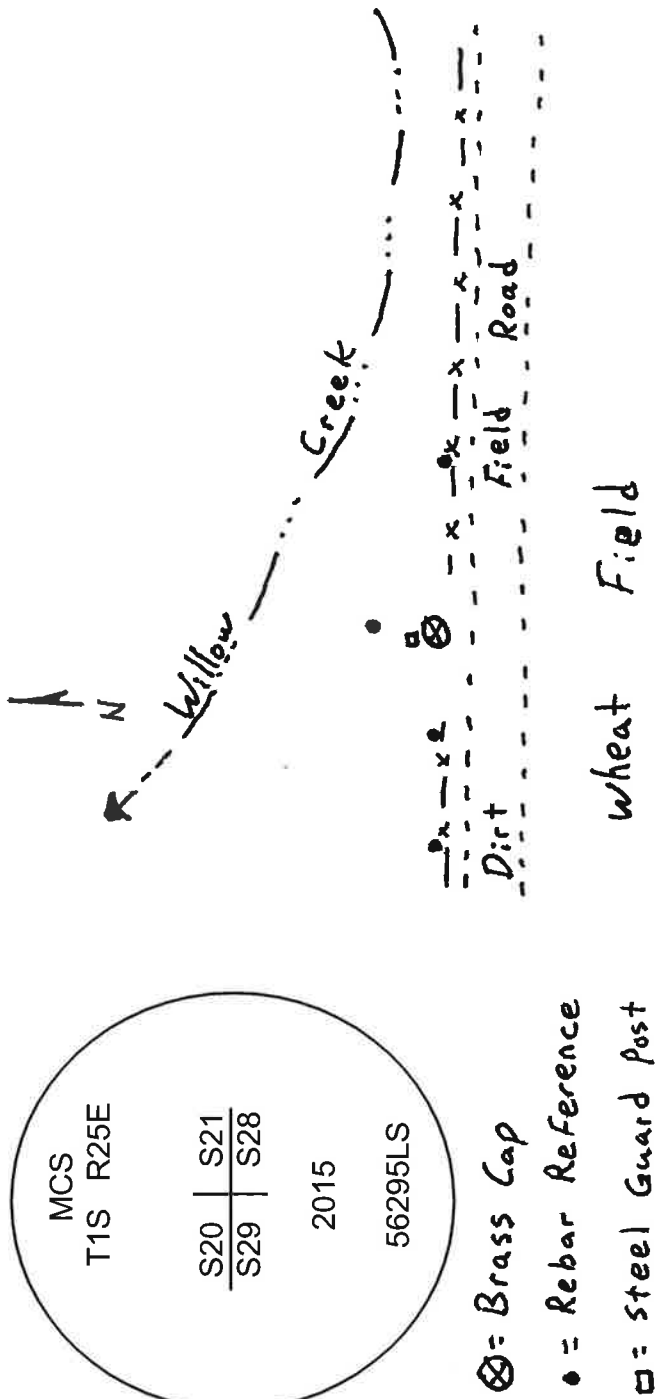

**MONUMENT (S) AND ACCESSORIES SET (Procedures and Description)**

I set a 2 3/8" brass cap on a 1 1/2" x 30" galvanized iron pipe 30 inches in the ground at the intersection of the fences and plow berm as described above.

For references, I set four, 5/8" by 24" rebars with 1.25" orange plastic caps stamped WTS and 56295LS as described below:

- an iron rebar bears S88°27'30"W, 75.14 feet under the existing fence;
- an iron rebar bears S88°44'02"W, 121.02 feet under the existing fence;
- an iron rebar bears N0°12'09"E, 35.90 feet;
- an iron rebar bears N89°24'11"E, 100.89 feet under the existing fence;

Measurements were made with a Trimble RTK GPS.

Location and comments

Witnessed by:  
David Quittschreiber

Compass Declination

Surveyors Seal

RECEIVED BY:

Morrow County Surveyor

Date: 9-28-2015

Rec'd By: S.K.H.

No. 1S25R9

Survey No. 2015-1748C

Firm / Agency  
Morrow County Surveyor

Address  
P.O. Box G

Pilot Rock, Or. 97868

Party Chief

Kristina Powell

