

OREGON CORNER RESTORATION FORM

Section 27 Township 1S Range 25E
County Morrow Date: September 2, 2015

Corner Designation: 1S25T13

Condition Report Only
Not found _____
Remonumented x
Unrecorded _____
Surveyed in x
Referenced out x


1/4 corner common to sections 27 and 28 T1S, R25E, W.M., Morrow County, Oregon.

Previous Renewals / Surveys, etc.

Corner was originally set by B.J. Pengra under contract No. 119 Dated February 16, 1867. His record reads: Drove charred stake and raised mound as per instructions as 1/4 Sec. corner. In survey D-623-K in folder 624, David Krumbain held a proportionate point but did not monument it.


Monument and Accessories found: (condition and source)
None. The point falls in the northerly ditch bottom of Oregon Highway 74.

DIAGRAM

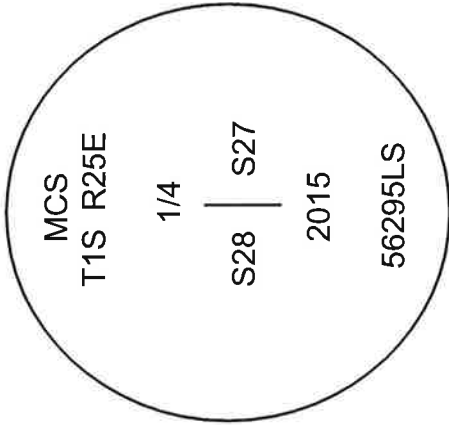

⊗ = Brass Cap
● = Rebar Reference

SKETCH

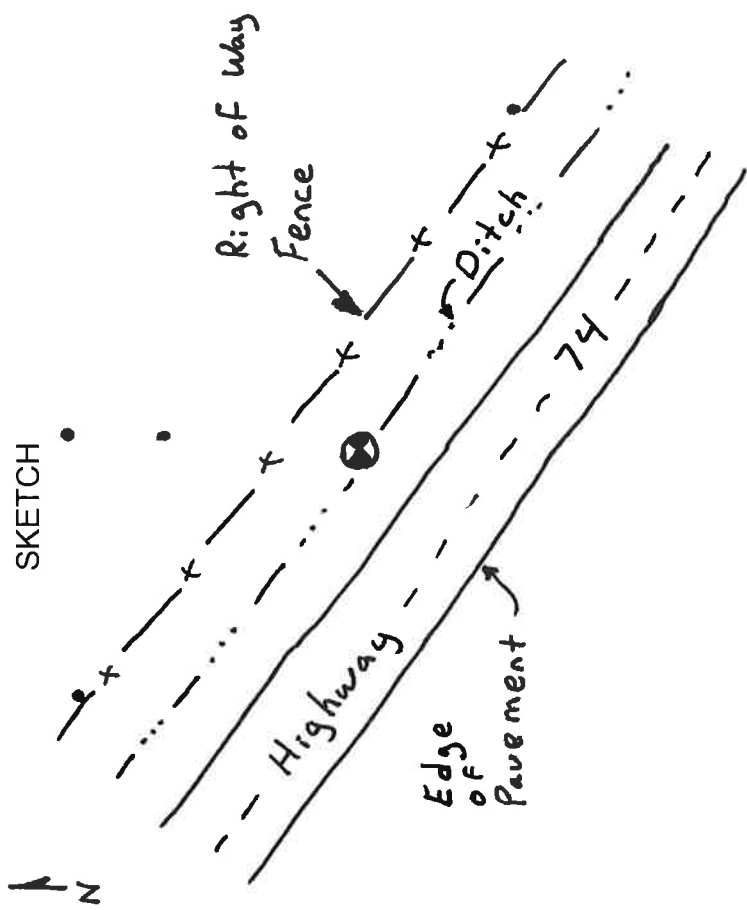

MONUMENT (S) AND ACCESSORIES SET (Procedures and Description)

At the proportionate point, I set a 2 1/2" brass cap on a 1 1/2" x 30" galvanized iron pipe 30 inches in the ground stamped as shown in the diagram above.

For references, I set four 5/8" by 24" rebars with 1.25" orange plastic caps stamped WTS and 56295LS as described below:

- a rebar bears N49°52'20"W, 54.03 feet under the north right of way fence;
- a rebar bears S75°50'58"E, 50.90 feet under the north right of way fence;
- a rebar bears N2°25'12"W, 38.91 feet 6 inches below the surface;
- a rebar bears N1°10'36"W, 70.13 feet 12 inches below the surface;

Measurements to the cap and references were made with a Trimble RTK GPS system.

Location and comments
Witnessed by:
David Quittschreiber

Compass Declination

Surveyors Seal

RECEIVED BY:
Morrow County Surveyor

Date: 9-20-2015

Rec'd By: S. K. H.

No. 1S25 T13

Survey No. 2015-1748C

Firm / Agency
Morrow County Surveyor
Address
P.O. Box G
Pilot Rock, Or. 97868
Party Chief
Kristina Powell

REGISTERED PROFESSIONAL LAND SURVEYOR
Stephen K. Haddock
 OREGON
 JULY 9, 2001
 STEPHEN K. HADDOCK
 56295LS
 RENEWS: 6-30-17