

OREGON CORNER RESTORATION FORM

Section 27 Township 1S Range 25E
County Morrow Date: September 3, 2015


Corner Designation: 1S25T17 x Condition Report Only

1/4 corner common to sections 26 and 27 T1S, R25E, W.M., Morrow County, Oregon.

Previous Renewals / Surveys, etc.
Corner was originally set by B.J. Pengra under contract No. 119 Dated February 16, 1867. His record reads: Drove Charred Stake and raised mound. In Survey D-623-K in folder 624, Dave Krumbein set a brass cap. In survey C-1348-M Gary Wagner set a brass cap from the record from folder 624.


Monument and Accessories found: (condition and source)
The brass cap set by Wagner at a 4 way fence intersection. Also, four 5/8" iron rebar references assumed to be by Wagner.

DIAGRAM

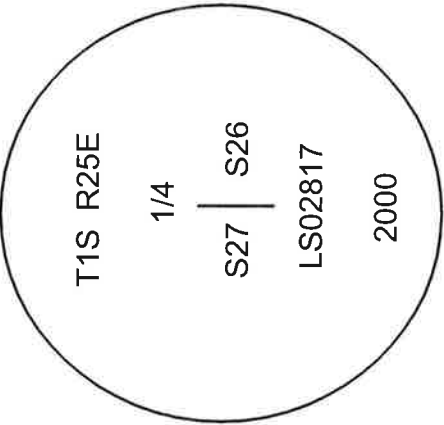

⊗ = Brass Cap
● = Rebar Reference

SKETCH

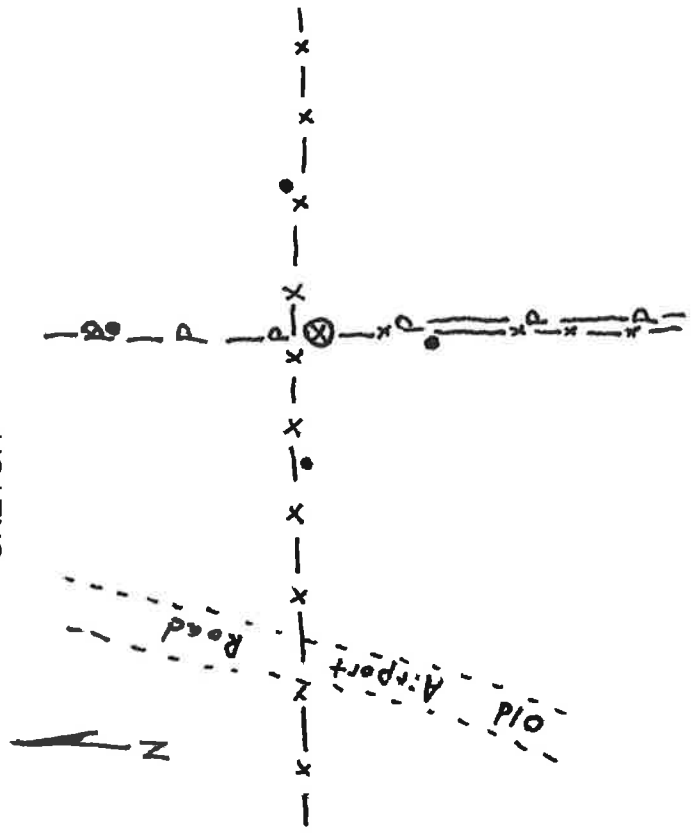

MONUMENT (S) AND ACCESSORIES SET (Procedures and Description)
None. Condition report only.

I found four 5/8" iron rebar references as described below:
a rebar bears N1°24'56"E, 100.73 feet approximately 10 inches south of a power pole;
a rebar bears N88°33'01"W, 33.45 feet on the south side of a fence;
a rebar bears S88°00'59"E, 26.58 feet on the north side of a fence;
a rebar bears S0°08'20"E, 33.45 feet;

Measurements to the cap and references were made with a Trimble RTK GPS system.

Location and comments
Witnessed by:
Brenda Johnson
David Quittschreiber

Compass Declination

Surveyors Seal

RECEIVED BY:
Morrow County Surveyor
Date: 9-28-2015
Rec'd By: S.K.H.
No. 201525T17
Survey No. 2015-1748C

REGISTERED
PROFESSIONAL
LAND SURVEYOR
Stephen K. Haddock
OREGON
JULY 9, 2001
STEPHEN K. HADDOCK
56295LS

RENEWS: 6-30-17