

**OREGON CORNER RESTORATION FORM**

Section 28 Township 1S Range 25E  
County Morrow Date: September 2, 2015

Corner Designation: 1S25T9

Condition Report Only  
Not found \_\_\_\_\_  
Remonumented x  
Unrecorded \_\_\_\_\_  
Surveyed in \_\_\_\_\_  
Referenced out x

1/4 corner common to sections 28 and 29 T1S, R25E, W.M., Morrow County, Oregon.


Previous Renewals / Surveys, etc.

Corner was originally set by B.J. Pengra under contract No. 119 Dated February 16, 1867. His record reads: Set a stone 16x12x10 inches as 1/4 Sec. Corner. In survey 1451, Jud Coppock said: Set brass cap from evidence.


Monument and Accessories found: ( condition and source )

At the position determined by ties to Coppock's survey I found a 10 inch spike driven in the decayed remains of a fence corner post with fences running south and west.

**DIAGRAM**

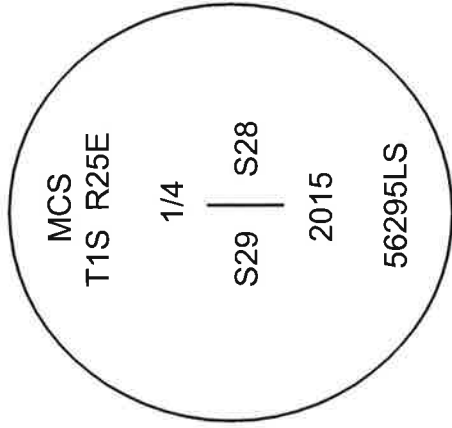

**SKETCH**

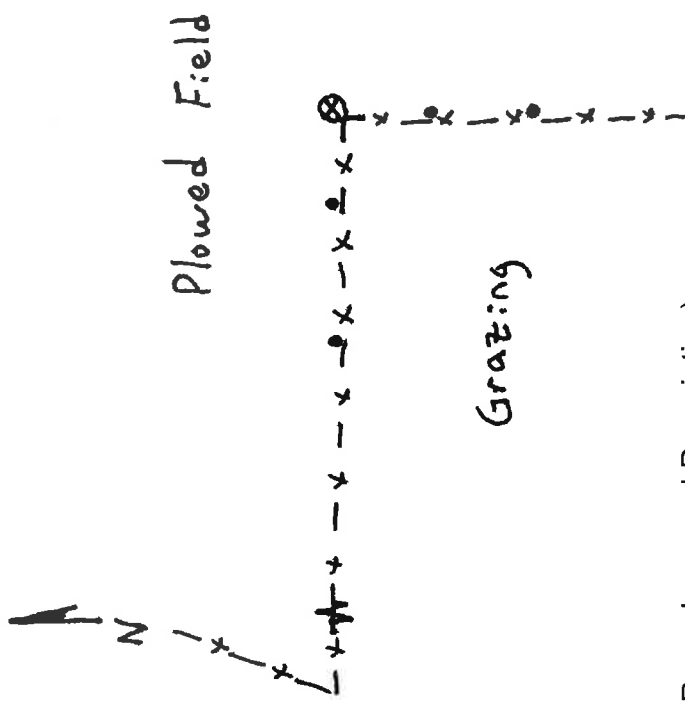

- ⊗ = Brass Cap
- = Rebar Reference

**MONUMENT (S) AND ACCESSORIES SET (Procedures and Description)**

At the position of the found spike I set a 2 1/2" brass cap on a 1 1/2" x 30" galvanized iron pipe 30 inches in the ground stamped as shown in the diagram above.

For references, I set four 5/8" by 24" rebars with 1.25" orange plastic caps stamped WTS and 56295LS as described below:

- a rebar bears S89°31'32"W, 100.77 feet under the existing fence;
- a rebar bears S88°16'06"W, 34.96 feet under the existing fence;
- a rebar bears S0°55'00"E, 37.04 feet under the existing fence;
- a rebar bears S0°43'59"E, 71.32 feet under the existing fence;

Measurements to the cap and references were made with a Trimble RTK GPS system.

Location and comments  
Witnessed by:  
David Quittschreiber

Compass Declination

Surveyors Seal

**RECEIVED BY:**

Morrow County Surveyor

Date: 9-28-2015

Rec'd By: S.K.H.

No. 1525 T9

Survey No. 2015-1748C

Firm / Agency  
Morrow County Surveyor

Address

P.O. Box G

Pilot Rock, Or. 97868

Party Chief

Kristina Powell

