

OREGON CORNER RESTORATION FORM

Section 27 Township 1S Range 25E
County Morrow Date: August 11, 2015

Corner Designation: 1S25V13

Condition Report Only
Not found
Remonumented
Unrecorded
Surveyed in
Referenced out
 x

Corner common to sections 27, 28, 33, and 34, T1S, R25E, W.M., Morrow County, Oregon.


Previous Renewals / Surveys, etc.

The corner was originally set by B.J. Pengra under contract 119 dated February 15, 1867. His record reads: Drove charred stake and raised mound as corner to Sections 27, 28, 33 & 34. In 1979 under survey D-256-K folder 605, Dave Krumbain states: found 2 in. iron pipe. In survey 1451 Judson Coppock states: Set brass cap.

Monument and Accessories found: (condition and source)


Found the brass cap by Coppock. The 2 inch iron pipe is 0.4 feet north of the brass cap and is 1 inch above ground. Measurements show that the pipe has been moved from its record location.

DIAGRAM

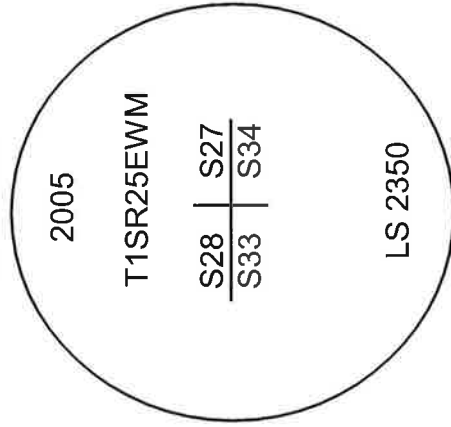

- = Brass Cap
- = 2" Iron Pipe
- = Rebar References

SKETCH

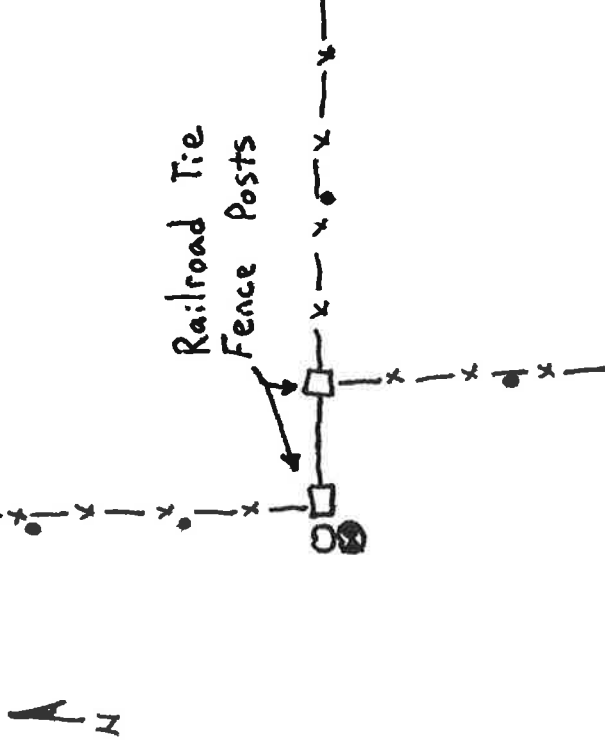

MONUMENT (S) AND ACCESSORIES SET (Procedures and Description)

No change was made to the corner monument. The brass cap is stamped as shown in the diagram above.

For references, I set four, 5/8" by 24" rebars with 1.25" orange plastic caps stamped WTS and 56295LS as described below:

- an iron rebar bears N00°29'26"W, 67.37 feet under the existing fence;
 - an iron rebar bears N1°01'01"W, 24.31 feet under the existing fence;
 - an iron rebar bears S89°14'18"E, 27.19 feet under the existing fence;
 - an iron rebar bears S9°51'00"E, 37.95 feet under the existing fence;
- The moved 2" iron pipe bears N0°43'37"E 0.40 feet;

Measurements were made with a Trimble RTK GPS.

Location and comments
Witnessed by:

Compass Declination

Surveyors Seal

RECEIVED BY:
Morrow County Surveyor
Date: 9-28-2015
Rec'd By: S.K.H.
No. 1525V13
Survey No. 2015-174BC

Firm / Agency
Morrow County Surveyor
Address
P.O. Box G
Pilot Rock, Or. 97868
Party Chief
Kristina Powell



Stephen K. Haddock

RENEWS: 6-30-17