

OREGON CORNER RESTORATION FORM

Section 27 Township 1S Range 25E
County Morrow Date: September 2, 2015

Corner Designation: 1S25V15

Condition Report Only
Not found
Remonumented
Unrecorded
Surveyed in
Referenced out X

Quarter corner common to sections 27 and 34, T1S, R25E, W.M., Morrow County, Oregon.


Previous Renewals / Surveys, etc.

Corner originally set by B.J. Pengra under contract No. 119 dated February 15, 1867. His record reads: Drove charred stake and raised mound as per instructions for 1/4 Sec. Corner. In Survey D-256-K in folder 605, Dave Krumbein set a brass cap.


Monument and Accessories found: (condition and source)

I found the brass cap set by Krumbein in good condition with an elevation of 1436.35 stamped along the west edge of the cap.

DIAGRAM

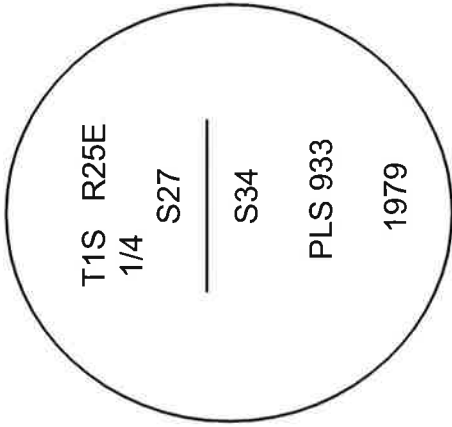

SKETCH
Remains of R/W Fence
Abandoned Railroad Grade
House
Driveway

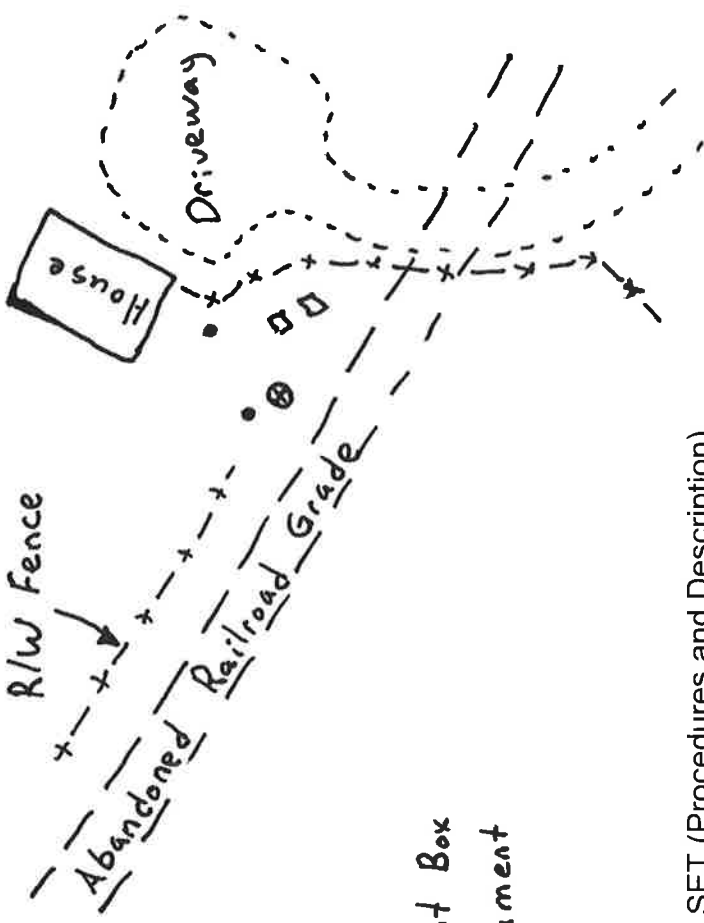

- = Brass Cap in Monument Box
- ⊗ = Brass Cap corner Monument
- = Rebar Reference

MONUMENT (S) AND ACCESSORIES SET (Procedures and Description)
I held the monument set by Krumbein as the corner point.

For references I set two, 5/8" by 24" rebars with 1 1/8" orange plastic caps attached, stamped WTS and 56295LS as described below:
an iron rebar bears N57°01'55"E, 45.62 feet;
an iron rebar bears N60°20'26"W, 7.98 feet;
a brass cap in a monument box from survey D-294-K-611 bears S71°33'24"E, 57.26 feet;
a brass cap in a monument box from survey D-294-K-611 bears S74°48'08"E, 52.80 feet:

The monument and references were tied using a Trimble R7/R8 RTK GPS.

Location and comments
Witnessed By:
Brenda Johnson
David Quittschreiber

Compass Declination

Surveyors Seal

RECEIVED BY:
Morrow County Surveyor
Date: 9-28-2015
Rec'd By: S.K.H.
No. 1S25V15
Survey No. 2015-1748C

Firm / Agency
Morrow County Surveyor
Address
P.O. Box G
Pilot Rock, Or. 97868
Party Chief
Kristina Powell

REGISTERED PROFESSIONAL LAND SURVEYOR
Stephen K. Haddock
OREGON
JULY 9, 2001
STEPHEN K. HADDOCK
56295LS
RENEWS: 6-30-17