

**OREGON CORNER RESTORATION FORM**


Section 36 Township 1S Range 25E  
 County Morrow Date: October 15, 2013

Corner Designation: 1S25V25 Condition Report Only  
 Not found  
 Remonumented  
 Unrecorded  
 Surveyed in  
 Referenced out

Previous Renewals / Surveys, etc.  
 Corner originally set by B.J. Pengra under contract No. 119 dated February 15, 1867. His record reads: Set a stone, 16x12x10 as the corner to sections 30, 31, 25 & 36. Judson Coppock, in Partition Plat 2000-14 calls for a well constructed mound of stones around a vertical center stone.

Monument and Accessories found: ( condition and source )  
 A mound of stone with a 16x12x10 basalt stone in the center set vertically at the projected intersection of fences running south and east.

**DIAGRAM**

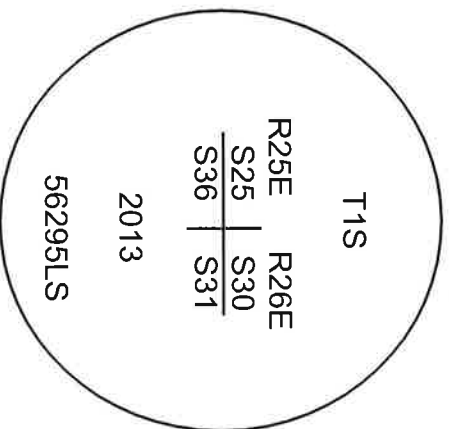

**SKETCH**

**MONUMENT (S) AND ACCESSORIES SET (Procedures and Description)**  
 I set a 1 1/2" x 30" galvanized iron pipe with a 2 1/4" brass cap stamped as shown in the diagram above at the position of the original stone in the original mound of stone. I buried the original stone along side.

For references, I set four, 5/8" by 24" rebars with 1 1/8" orange plastic caps attached, stamped WTS and 56295LS as described below:  
 an iron rebar bears N88°11'18"W, 38.11 feet;  
 an iron rebar bears N0°51'19"E, 53.33 feet;  
 an iron rebar bears S89°18'48"E, 76.27 feet;  
 an iron rebar bears S2°03'28"E, 168.16 feet;

The monument and references were tied using a Trimble R7/R8 RTK GPS.

Location and comments

Compass Declination

Surveyors Seal

RECEIVED BY:

Morrow County Surveyor

Date: 12-21-2013

Rec'd By: Stephen K. Haddock

No. \_\_\_\_\_

Firm / Agency  
 Witness Tree Surveying  
 Address

P.O. Box G  
 Pilot Rock, Or. 97868  
 Party Chief  
 Stephen K, Haddock

REGISTERED  
 PROFESSIONAL  
 LAND SURVEYOR

*Stephen K. Haddock*

OREGON  
 JULY 9, 2001  
 STEPHEN K. HADDOCK  
 56295LS

RENEWS: **6-30-15**