

**OREGON CORNER RESTORATION FORM**

Section 29 Township 1S Range 25E  
County Morrow Date: September 1, 2015

Corner Designation: 1S25V5 Condition Report Only  
Not found \_\_\_\_\_  
Remonumented x  
Unrecorded \_\_\_\_\_  
Surveyed in \_\_\_\_\_  
Referenced out x

Corner common to sections 29, 30, 31, and 32, T1S, R25E, W.M., Morrow County, Oregon.

Previous Renewals / Surveys, etc.  
The corner was originally set by B.J. Pengra under contract 119 dated February 15, 1867. His record reads: Drove charred stake and raised mound as corner to Sections 29, 30, 31, & 32. In survey 1451, Judson Coppock said: Set brass cap from evidence.

Monument and Accessories found: ( condition and source )  
At the point determined by ties to Coppock's survey I found a PK nail in the top of a broken off stub of a 5" locust fence post. I also found remains of two other types and ages of wood post in the hole below the locust post. there were plow berms running east, west, and south from this point.


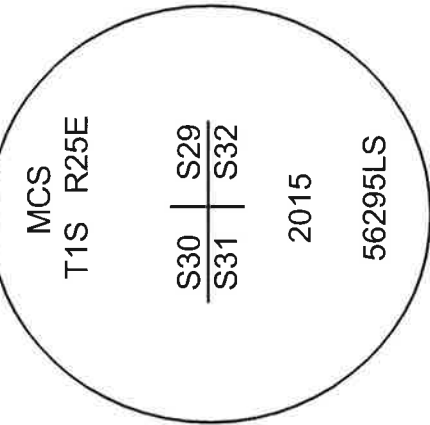


DIAGRAM SKETCH

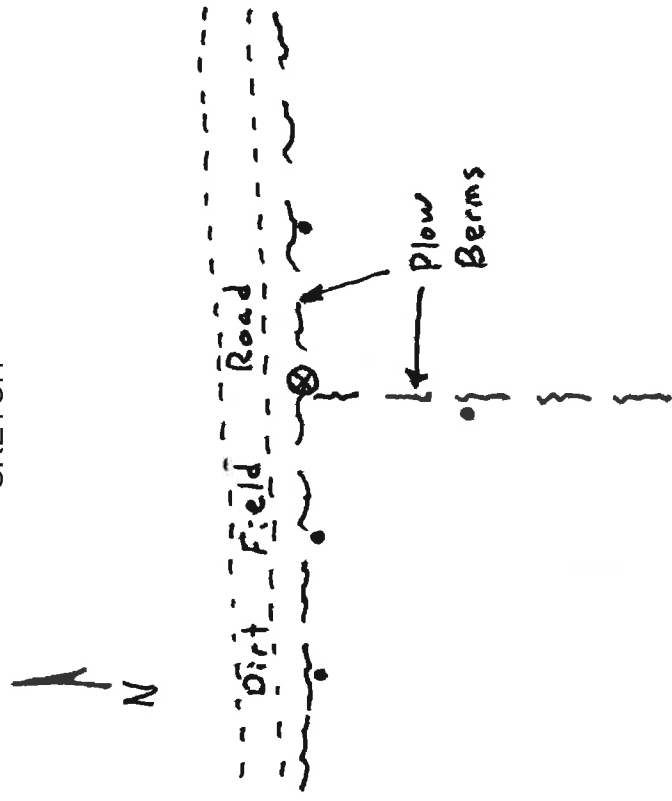

⊗ = Brass Cap  
• = Rebar Reference

MONUMENT (S) AND ACCESSORIES SET (Procedures and Description)  
At the position of the PK nail I set a 2 1/2" brass cap on a 1 1/2" galvanized iron pipe 30 inches in the ground. The cap was stamped as shown in the diagram above.

For references, I set four, 5/8" by 24" rebars with 1.25" orange plastic caps stamped WTS and 56295LS as described below:  
an iron rebar bears N89°40'34"W, 49.66 feet 12 inches below the surface;  
an iron rebar bears N89°54'39"W, 20.29 feet 15 inches below the surface;  
an iron rebar bears S88°04'59"E, 23.78 feet 15 inches below the surface;  
an iron rebar bears S11°32'50"W, 25.76 feet 4 inches below the surface;

Measurements were made with a Trimble RTK GPS.

Location and comments  
Witnessed by: David Quittschreiber Compass Declination \_\_\_\_\_ Surveyors Seal \_\_\_\_\_

RECEIVED BY: \_\_\_\_\_  
Morrow County Surveyor  
Date: 9-28-2015  
Rec'd By: S.K.H.  
No. 1S25V5  
Survey No. 2015-1748C

REGISTERED PROFESSIONAL LAND SURVEYOR  
*Stephen K. Haddock*  
OREGON  
JULY 9, 2001  
STEPHEN K. HADDOCK  
56295LS  
RENEWS: 6-30-17