

OREGON CORNER RESTORATION FORM

Section 28 Township 1S Range 25E
County Morrow Date: September 3, 2015

Corner Designation: 1S25V9

Condition Report Only
Not found _____
Remonumented x
Unrecorded _____
Surveyed in _____
Referenced out x



Corner common to sections 28, 29, 32, and 33, T1S, R25E,
W.M., Morrow County, Oregon.

Previous Renewals / Surveys, etc.

The corner was originally set by B.J. Pengra under contract 119 dated February 15, 1867. His record reads: Set a stone 22x8x6 inches corner to Sections 28, 29, 32, & 33. In survey folder 1451 Judson Coppock said: Set brass cap from evidence. (However, the data on the map indicate it was by double proportion).

Monument and Accessories found: (condition and source)
None. The position falls within the excavated area on the east side of old grain bins.

DIAGRAM

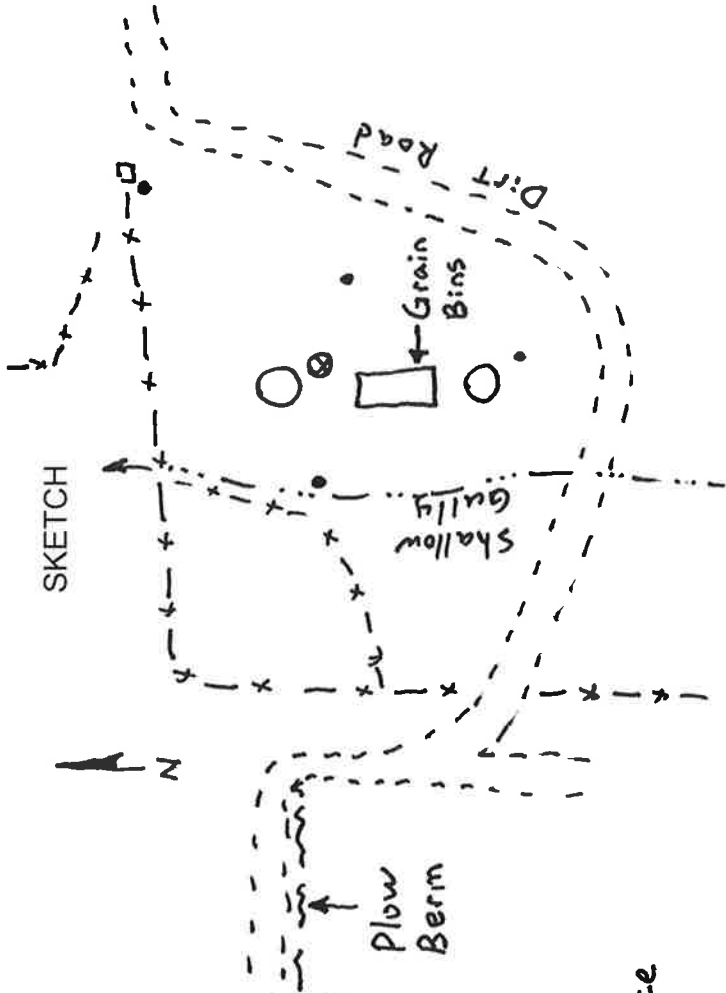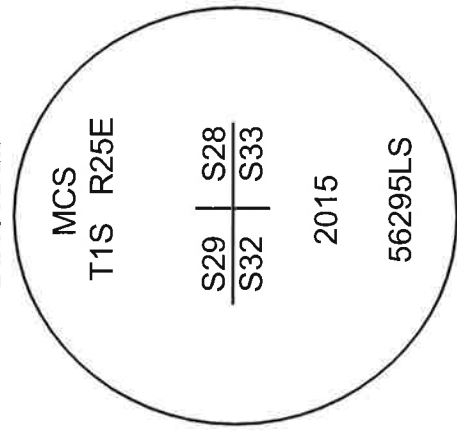

⊗ = Brass Cap
● = Rebar Reference

MONUMENT (S) AND ACCESSORIES SET (Procedures and Description)

At the corner point determined by intersection of the fence from the north and a plow berm to the west I set a 2 1/2" brass cap on a 1 1/2" x 30" galvanized iron pipe 30 inches in the ground stamped as shown in the diagram above. From this corner the unmonumented proportionate point by Coppock bears S19°13'52"E 6.25 feet.

For references, I set four, 5/8" by 24" rebars with 1.25" orange plastic caps stamped WTS and 56295LS as described below:

- an iron rebar bears N45°03'18"E, 133.12 feet at the bottom of a railroad tie fence post;
- an iron rebar bears S77°40'30"E, 36.16 feet 16 inches below the surface;
- an iron rebar bears S0°23'00"W, 67.70 feet 18 inches below the surface;
- an iron rebar bears S87°47'49"W, 81.48 feet 15 inches below the surface;

Measurements were made with a Trimble RTK GPS.

Location and comments
Witnessed by:
David Quittschreiber

Compass Declination

Surveyors Seal

RECEIVED BY:
Morrow County Surveyor


Date: 9-28-2015

Rec'd By: S.K.H.

No. 1S25V9

Survey No. 2015-1748C

Firm / Agency
Morrow County Surveyor
Address
P.O. Box G
Pilot Rock, Or. 97868
Party Chief
Kristina Powell

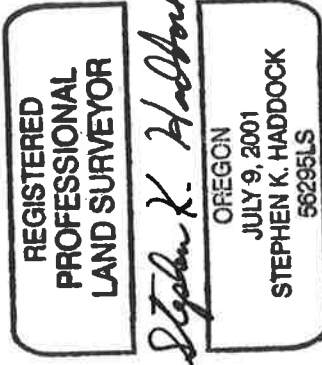

RENEWS: 6-30-17