

OREGON CORNER RESTORATION FORM

Section 34 Township 1S Range 25E
County Morrow Date: August 11, 2015

Corner Designation: 1S25X13

1/4 corner common to sections 33 and 34 T1S, R25E, W.M., Morrow County, Oregon.

Previous Renewals / Surveys, etc.


Corner was originally set by B.J. Pengra under contract No. 119 Dated February 16, 1867. His record reads: Set a stone 12x10x8 inches as 1/4 Sec. Corner. In survey 1451, Mr. Judson Coppock said: Set brass cap from evidence.

Condition Report Only
Not found
Remonumented
Unrecorded
Surveyed in
Referenced out
 x

Monument and Accessories found: (condition and source)

The brass cap set by Coppock at the intersection of the remains of fences north, south, east, and west.

DIAGRAM

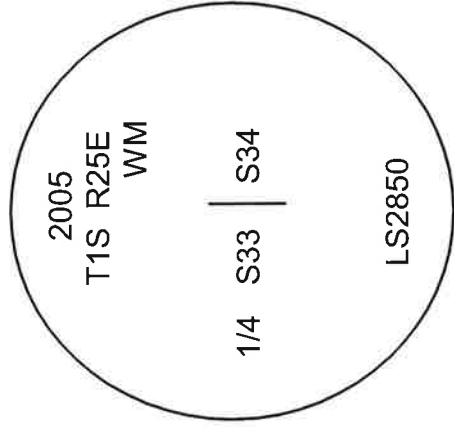

SKETCH



⊗ = Brass Cap
● = Rebar Reference

MONUMENT (S) AND ACCESSORIES SET (Procedures and Description)
Held monument as located by Coppock.

For references, I set four 5/8" by 24" rebars with 1.25" orange plastic caps stamped WTS and 56295LS as described below:
a rebar bears N88°00'42"W, 54.22 feet in a decayed fence along a plow berm;
a rebar bears N0°39'57"W, 24.77 feet 12 inches below the surface in the old fence;
a rebar bears N0°12'54"W, 68.74 feet at the foot of an old fence post;
a rebar bears N86°49'21"E, 27.90 feet at the foot of an old fence post;

Measurements to the cap and references were made with a Trimble RTK GPS system.

Location and comments
Witnessed by:
David Quittschreiber

Compass Declination

Surveyors Seal

RECEIVED BY:
Morrow County Surveyor
Date: 9-28-2015
Rec'd By: S.K.H.
No. 1525x13
Survey No. 2015-1748C

Firm / Agency
Morrow County Surveyor
Address
P.O. Box G
Pilot Rock, Or. 97868
Party Chief
Kristina Powell

