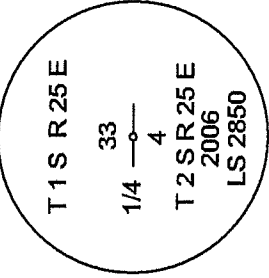
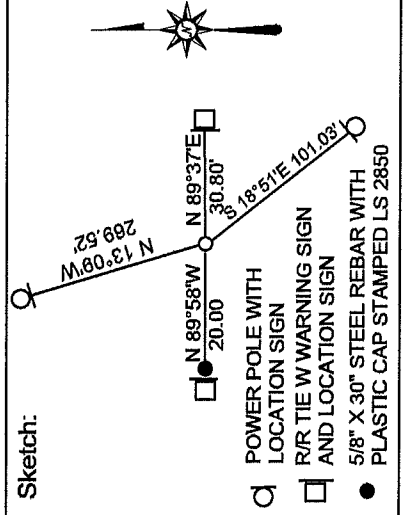
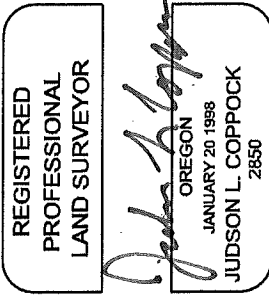


**OREGON PUBLIC LAND CORNER REPORT / RESTORATION REPORT**

MORROW COUNTY SURVEYOR'S OFFICE

SECTION 1/4 $\frac{33}{4}$	TOWNSHIP $\frac{T 1 S}{T 2 S}$	RANGE R 25 E OF THE WILLAMETTE MERIDIAN
MORROW COUNTY, OREGON		DATE: 1 MAY 2006
CORNER DESIGNATION:  1/4 CORNER COMMON TO SECTION 33 T 1 S, R 25 E AND SECTION 4, T 2 S, R 25 EAST OF THE W.M..		
Previous Renewals / Surveys, etc.  GLO CONTRACT 119, 15 FEB 1867 BY THOMPSON AND PENGRA. SET CHARRED STAKE.		
Monument(s) & Accessories Found: (Condition & Source)  EAST WEST FENCES ONLY		
Monument Detail:  	Sketch:  	Monument Set (Procedures and Description): SET 2 3/8" BRASS CAP STAMPED AS SHOWN ON A 2" ID X 30" GALV. STEEL PIPE FLUSH WITH SURFACE OF CLARKS CANYON ROAD. SURVEYED AND COMPUTED IN CONJUNCTION WITH A PARTITION PLAT FOR MUNKERS.  New Accessories: POWER POLE N 13°09' W 269.52I TO FACE OF BEARING OBJECT SIGN. R/R TIE FENCE POST N 87°37' E 30.80' TO FACE OF BEARING OBJECT SIGN. POWER POLE S 18°51' E 101.03' TO FACE OF BEARING OBJECT SIGN. 5/8" X 30" STEEL REBAR WITH PLASTIC CAP STAMPED LS 2850, N 89°58' W 20.00' GUARDED WITH "T" POST AND SIGN.
Location & Comments:  IN PAVEMENT OF CLARKS CANYON ROAD.		Compass Declination:  NOT DETERMINED
Firm / Agency  COPPOCK SURVEYING PO Box 495 HEPNER, OR 97836		SURVEYOR'S SEAL  REGISTERED PROFESSIONAL LAND SURVEYOR
Party Chief  JUDSON L. COPPOCK LS 2850		
Notes  SHANNON BENEFIT		
Witness		

RENEWAL DATE: DEC. 31, 2007

2-4