

OREGON CORNER RESTORATION FORM

Section 34 Township 1S Range 25E
County Morrow Date: August 11, 2015

Corner Designation: 1S25Z17

Condition Report Only
Not found
Remonumented
Unrecorded
Surveyed in
Referenced out x


Corner common to sections 34 and 35, T1S, and sections 2 and 3, T2S, R25E, W.M., Morrow County, Oregon.

Previous Renewals / Surveys, etc.


The corner was originally set by B.J. Pengra under contract 119 dated February 15, 1867. His record reads: Set a stone 16x10x8 as corner to sections 2, 3, 34, and 35. Judson Coppock under survey 1451 states: set a 2 3/8" brass cap attached to the top of a 2" galvanized steel pipe.

Monument and Accessories found: (condition and source)
Found the brass cap by Coppock as described. Found a 5/8" rebar to the northeast as described and found the bearing object signs as described in Coppock's corner certificate.

DIAGRAM

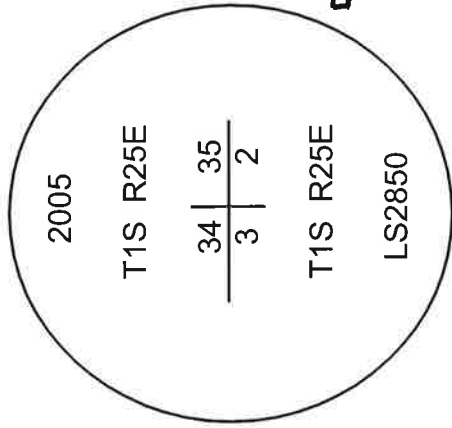

SKETCH

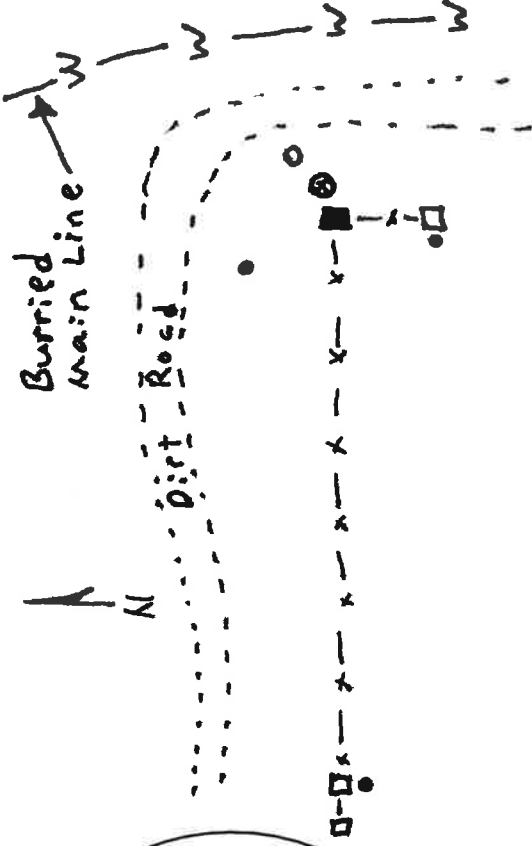

- ⊗ = Brass Cap
- = Coppock Rebar
- = New Rebar Reference
- ⊠ = Railroad Tie post

MONUMENT (S) AND ACCESSORIES SET (Procedures and Description)
I found and held the brass cap stamped as shown in the diagram above.

For references, I set three 5/8" by 24" rebars with 1.25" orange plastic caps stamped WTS and 56295LS as described below:
an iron rebar bears N45°05'46"W, 18.86 feet 18 inches below the surface;
an iron rebar bears S88°55'26"W, 75.16 feet on the south side of a railroad tie fence post;
an iron rebar bears S7°10'26"W, 7.79 feet on the west side of a railroad tie fence post;
The iron rebar by Coppock bears N48°00'30"E, 2.98 feet 12 inches below the surface;

Measurements were made with a Trimble RTK GPS.

Location and comments
Witnessed by:
Brenda Johnson
David Quittschreiber

Compass Declination

Surveyors Seal

RECEIVED BY:
Morrow County Surveyor
Date: 9-28-2015
Rec'd By: S.K.H.
No. 1525217
Survey No. 2015-1748C

Firm / Agency
Morrow County Surveyor
Address
P.O. Box G
Pilot Rock, Or. 97868
Party Chief
Kristina Powell

