

OREGON CORNER RESTORATION FORM

Section 32 Township 1S Range 25E
County Morrow Date: August 11, 2015

Corner Designation: 1S25Z9

Condition Report Only
Not found
Remonumented
Unrecorded
Surveyed in
Referenced out x


Corner common to sections 32 and 33, T1S, and sections 4 and 5, T2S, R25E, W.M., Morrow County, Oregon.

Previous Renewals / Surveys, etc.


The corner was originally set by B.J. Pengra under contract 119 dated February 15, 1867. His record reads: Set corner to sections 4, 5, 32, and 33. Drove charred stake and raised mound as per instructions. Judson Coppock under survey 1451 states: set a 2 3/8" brass cap attached to the top of a 2" galvanized steel pipe.

Monument and Accessories found: (condition and source)
Found the brass cap by Coppock as described. Found a 5/8" rebar to the northwest as described. Found the bearing object signs as described. The "T" post had been moved.

DIAGRAM

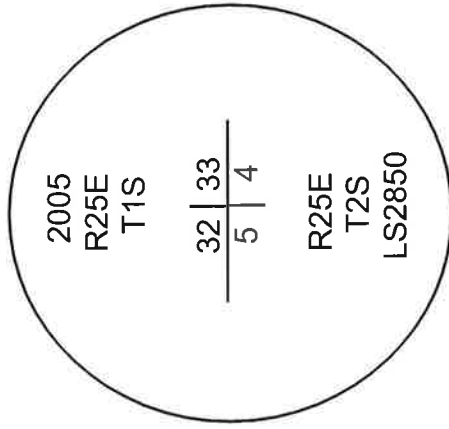

SKETCH

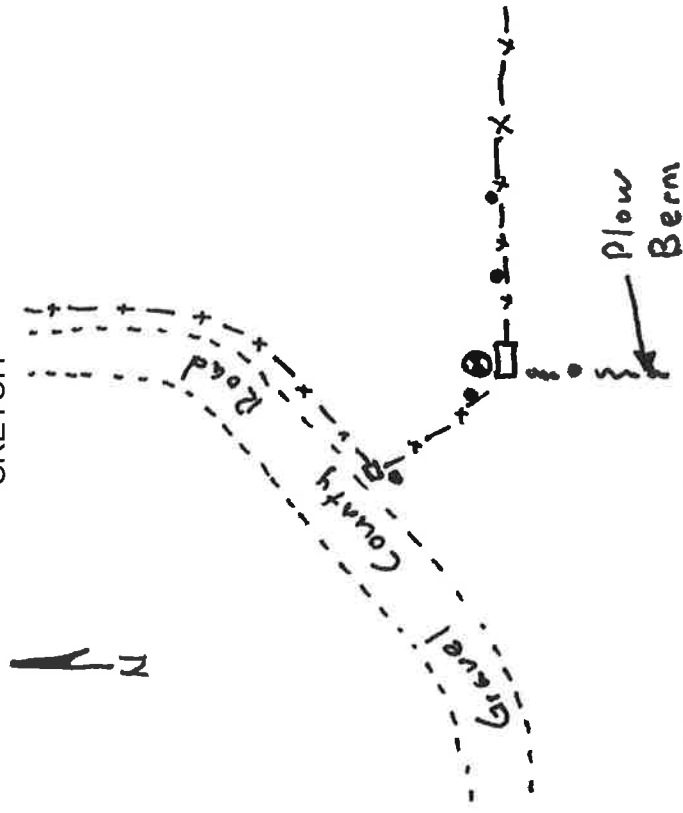

- = Railroad Tie Fence Post
- ⊙ = Brass Cap
- = Rebar Reference

MONUMENT (S) AND ACCESSORIES SET (Procedures and Description)
I found and held the brass cap stamped as shown in the diagram above.

For references, I set four, 5/8" by 24" rebars with 1.25" orange plastic caps stamped WTS and 56295LS as described below:
an iron rebar bears N38°42'04"W, 137.96 feet at the bottom of a railroad tie fence post;
an iron rebar bears S89°14'23"E, 22.53 feet under the existing fence;
an iron rebar bears S89°50'04"E, 45.54 feet under the existing fence;
an iron rebar bears S2°54'36"W, 19.44 feet 18 inches below the surface in a plow berm;
The iron rebar by Coppock bears N37°41'57"W, 5.00 feet 12 inches below the surface;

Measurements were made with a Trimble RTK GPS.

Location and comments
Witnessed by:
Brenda Johnson
David Quittschreiber

Compass Declination

Surveyors Seal

RECEIVED BY:
Morrow County Surveyor
Date: 9-28-2015
Rec'd By: S.K.H.
No. 152529
Survey No. 2015-1748C

Firm / Agency
Morrow County Surveyor
Address
P.O. Box G
Pilot Rock, Or. 97868
Party Chief
Kristina Powell

REGISTERED
PROFESSIONAL
LAND SURVEYOR

Stephen K. Haddock

OREGON
JULY 9, 2001
STEPHEN K. HADDOCK
56295LS

RENEWS: 6-30-17